* Replaces Permit issued 20 June 08

IREDELL COUNTY HEALTH DEPARTMENT

STATESVILLE 704-878-5305 (ad) MOORESVILLE 704-664-5281

IMPROVEMENT PERMIT / AUTHORIZATION TO CONSTRUCT / OPERATION PERMIT / EXISTING SYSTEM INSPECTION

PERMIT # 120657 PIN # 3793-51-~~0281~~ 1216 DATE 27 April 09

OWNER or APPLICANT LKN Builders PHONE: Business (704) 201-9173 Home:

OWNER or APPLICANT ADDRESS 7862 Sarah Dr. Denver, N.C.

LOCATION / DIRECTIONS Sharon School Rd. Turn onto Muck Mill Rd. Turn into Golf Course. Last gate-side - on left.

SUBDIVISION Buffalo Shoals Natl Golf Club BLOCK / SECTION LOT # 49+50 LOT AREA 1.23ac. DESIGN FLOW 480 gpd L.T.A.R. 0.39/ft²/d

Paid #305.00 for Relayout 5/28/09 - Vian

Septic Tank 1000	Gallons: STB 760	Date 11-18-08	☑ New System ☐ Repair ☐ Expansion System Type I II ◉ IV V VI	☑ Residence	No. Bedrooms 4	Water Supply
Pump Tank	Gallons: PT	Date	System Description: 25% Reduction	☐ Business	No. Persons	☐ Private
Pump Make	Model	Serial #	Repair System Description: 50% Reduction - LPP	☐ Other	No. Employees	☑ Public
Nitrification Field No Fields 1	No Lines 10	Linear Feet 400	Maintenance Agreement Required ☐ YES ☑ NO	☐ Slab	☐ Crawl Space	☐ Community
Trench Width 36"	Max. Trench Bottom Depth 36'	Gravel Depth N/A	☑ GRAVITY ☐ PRESSURE	☑ Basement w/plumbing	☐ Basement w/o plumbing	

Comments / Conditions: Follow contour / Keep 5' away from erosion control ditch. Use Flow divider tee. Honor all setback requirements.

Comments / Conditions:

INITIAL SITE SKETCH

Please see attached site sketch.

AS BUILT SKETCH

Install as Drawn on Final sketch.

Permit can be suspended or revoked if any false information is supplied toward securing the permit / any unauthorized changes are made to the site / any unauthorized changes are made in the installation of the system.

☐ *IMPROVEMENT PERMIT w / plat valid without expiration.* ☑ *IMPROVEMENT PERMIT w / site plan valid for 60 mos.* ☑ *AUTHORIZATION TO CONSTRUCT valid for period equal to IMPROVEMENT PERMIT-not to exceed 60 mo.*

Owner / Applicant Signature: Date 5/28/09

Improvement Permit by: , R.S. Date 28 April 09

Authorization to Construct by: , R.S. Date 28 April 09

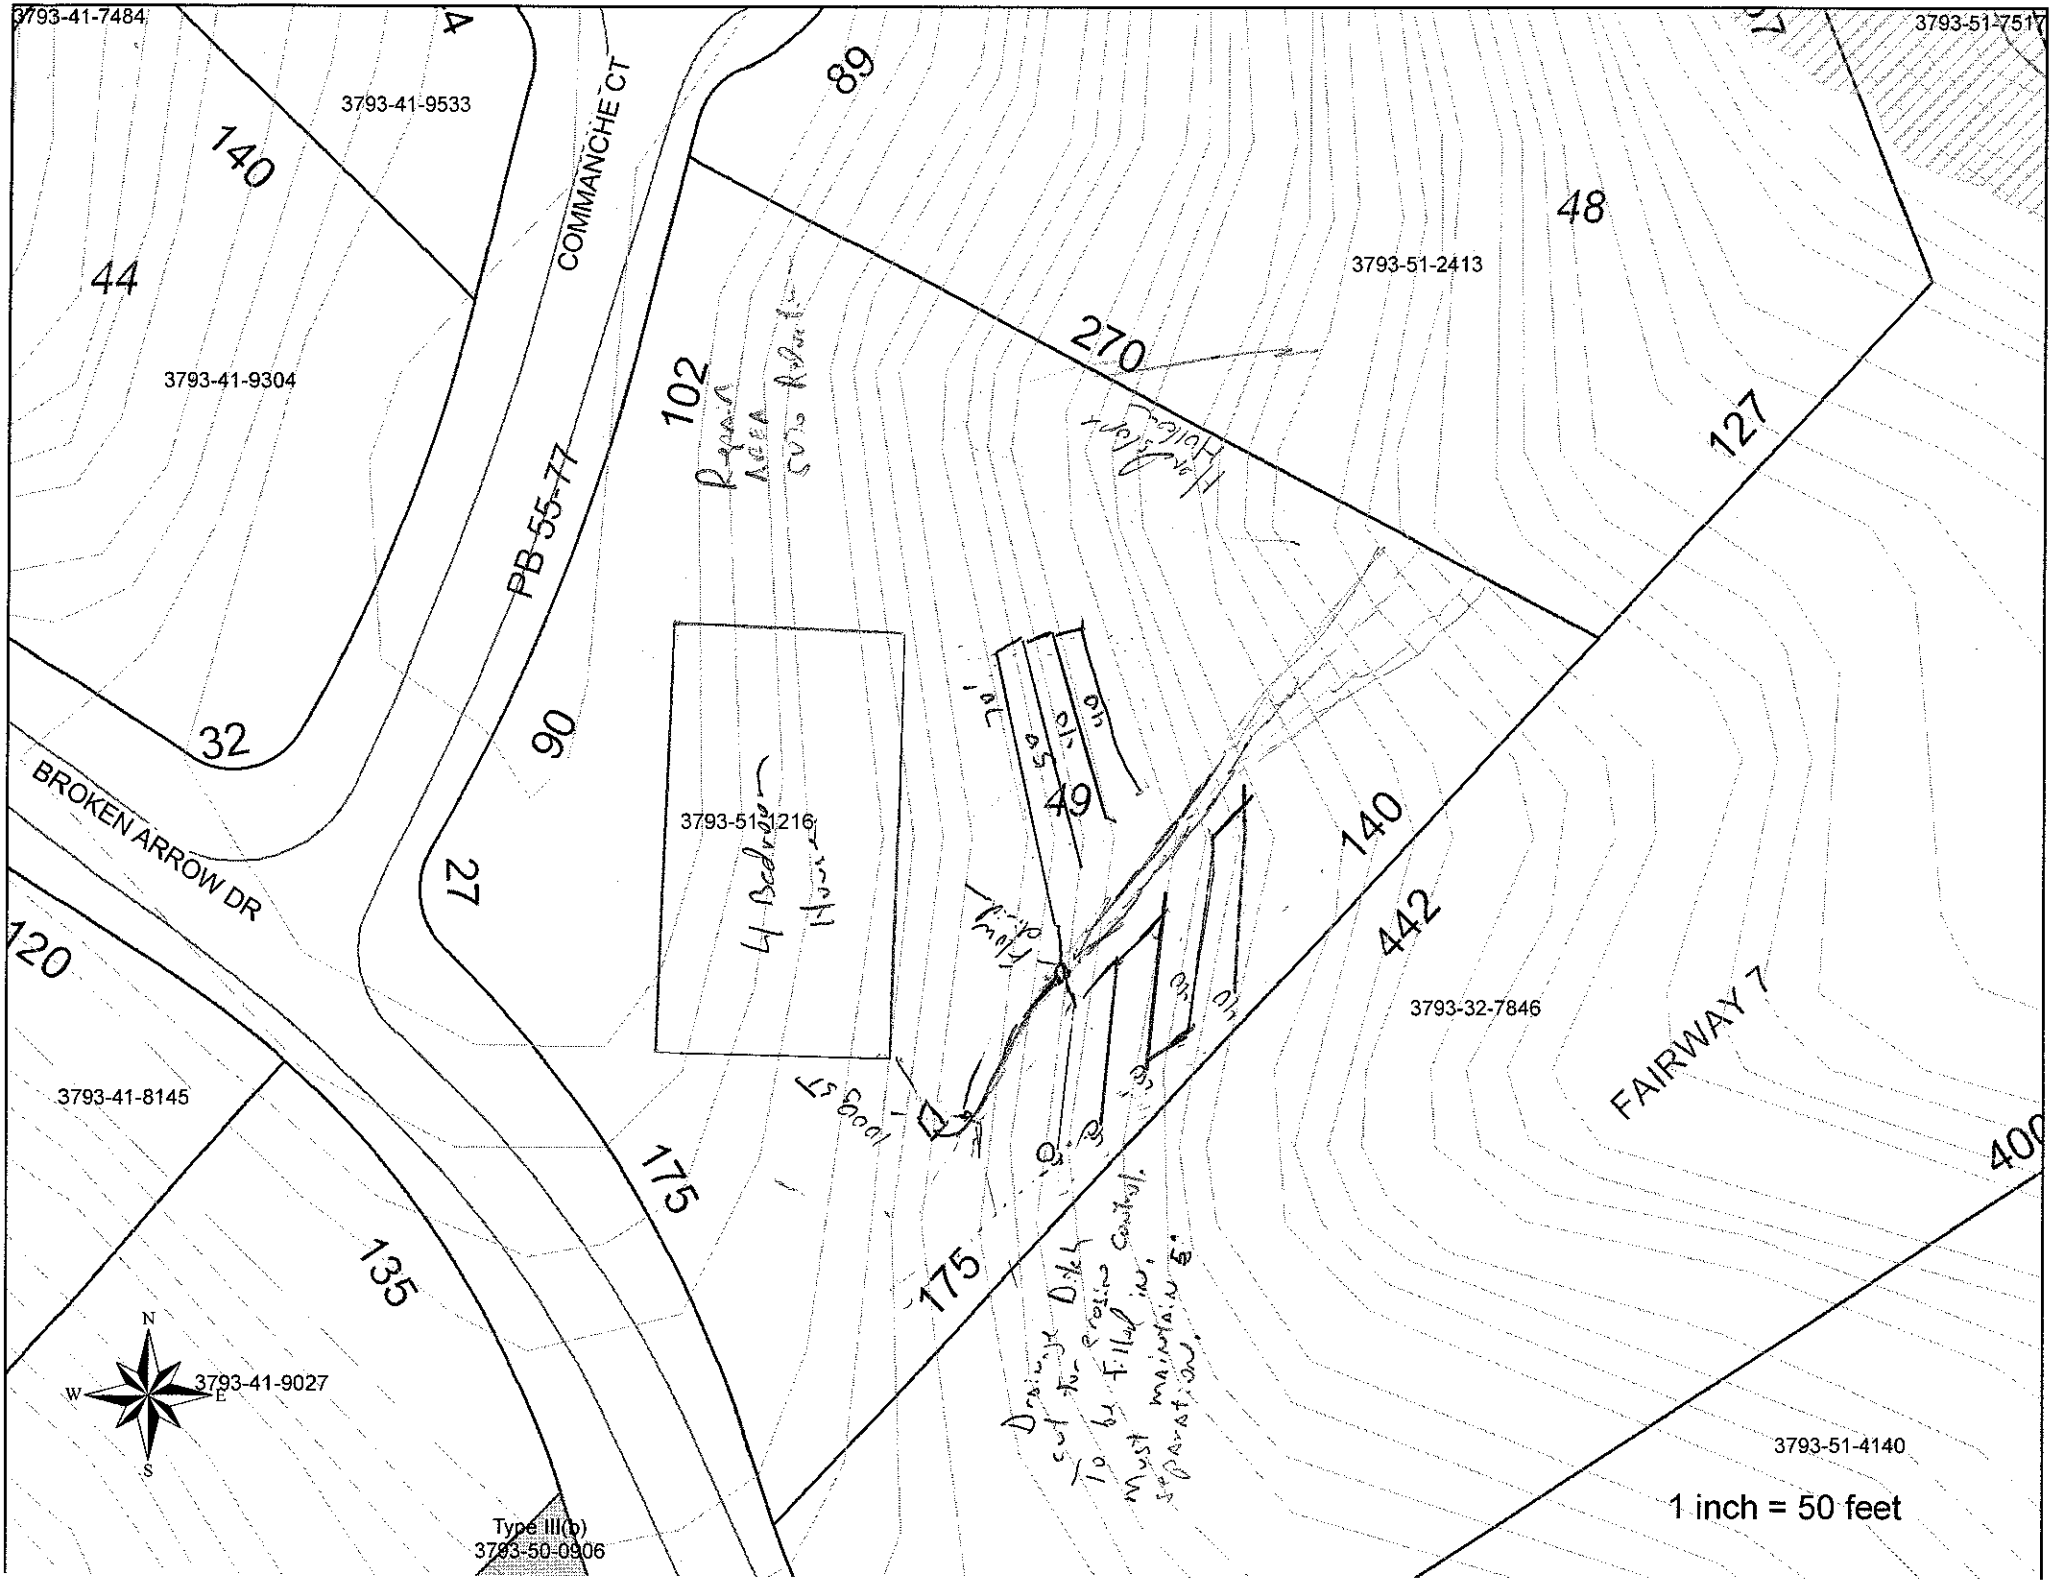
Installed by: A-1 Backhoe

Operation Permit by: , R.S. Date: 4 June 09

Existing System Inspected by: Date:

YOU SHOULD CONTACT A LOCATOR SERVICE PRIOR TO ANY EXCAVATION.

WHITE COPY Environmental Health YELLOW COPY (Final) Owner / Applicant PINK COPY (Initial) Owner / Applicant


3793-41-7484
3793-41-9533
COMMANCHE CT
3793-51-7517
89
48
3793-51-2413
140
44
3793-41-9304
270
102
PB 55-77
127
90
3793-51-1216
32
BROKEN ARROW DR
27
49
140
442
3793-32-7846
FAIRWAY 7
120
3793-41-8145
175
135
400
175
3793-41-9027
N
W
E
S
3793-51-4140
Type III(b)
3793-50-0906
1 inch = 50 feet