IREDELL COUNTY HEALTH DEPARTMENT - *ENVIRONMENTAL HEALTH* ☑ STATESVILLE OFFICE 704-878-5305 ☐ MOORESVILLE OFFICE 704-664-5281

IMPROVEMENT PERMIT / AUTHORIZATION TO CONSTRUCT / OPERATION PERMIT / EXISTING SYSTEM INSPECTION

PERMIT # 174513 PIN # 3793532424 DATE 9-28-12

OWNER First Third Bank APPLICANT: Aron Lampley PHONE: Home/Cell # 704-239-3693 Business # N/A

SITE ADDRESS 123 Taylormade Dr. OWNER / APPLICANT ADDRESS 4184 Hickory Hwy Statesville

SITE DIRECTIONS 40W TL Old Mtn Rd TR Beulah Rd / Mockmill TL Titleist Dr TR Maxfli Dr TR Taylormade Dr

SUBDIVISION Augusta Greens BLOCK / SECTION P2 LOT # 71 LOT AREA .0818acres DESIGN FLOW 360gpd L.T.A.R. 0.25

Septic Tank 1000 Gallons: STB 766 Date 7-21 ☑ New System ☐ Repair ☐ Expansion System Type I II III IV V VI

Pump Tank ____ Gallons: PT ____ Date ____ System Description: 25% Reduction

Pump Make ____ Model ____ Serial # ____ Repair System Description: 25% Reduction

No. Nitrification Fields: 1 No. Lines 4 Linear Feet 360' Maintenance Agreement Required ☐ YES ☑ NO

Trench Width 36" Max. Trench Bottom Depth 36" Gravel Depth N/A ☑ GRAVITY ☐ PRESSURE


☑ Residence No. Bedrooms 3 ☐ Business No. Persons ____ ☐ Other No. Employees ____ ☐ Slab ☑ Crawl Space ☐ Basement w/plumbing ☐ Basement w/o plumbing

Water Supply: ☐ Private ☑ Public ☐ Community

Comments / Conditions: Install a 25% Reduction System on contour with serial distribution. Grading for house site shall not exceed 1 foot excavation

- Red Polylok filter installed
- Quick4 Chambers installed
Water line is 10' from septic tank

INITIAL SITE SKETCH

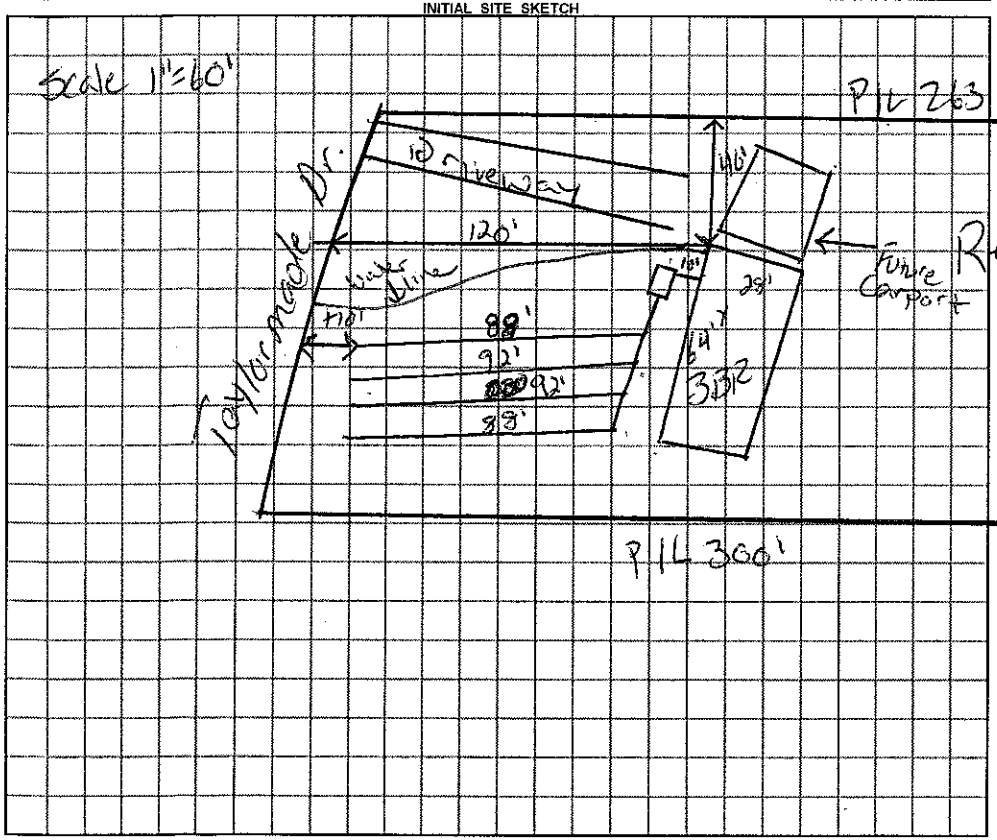

AS BUILT SKETCH

Permit can be suspended or revoked if any false information is supplied toward securing the permit / any unauthorized changes are made to the site / any unauthorized changes are made in the installation of the system.

☐ *IMPROVEMENT PERMIT with plat valid without expiration* ☑ *IMPROVEMENT PERMIT with ~~plat valid without expiration~~ site plan valid 60 mo.* ☑ *AUTHORIZATION TO CONSTRUCT* valid for period equal to IMPROVEMENT PERMIT--not to exceed 60 mo.

Owner / Applicant Signature: Deena Aree Date 10/1/12 Installed by: Groundbreakers

IMPROVEMENT PERMIT by: Justin Henderson REHS Date 9-28-12 OPERATION PERMIT by: Justin Henderson REHS Date 11-8-12

AUTHORIZATION TO CONSTRUCT by: Justin Henderson REHS Date 9-28-12 Existing System Inspected by: ____ REHS Date ____

YOU SHOULD CONTACT A LOCATOR SERVICE PRIOR TO ANY EXCAVATION

White Copy -- Environmental Health YELLOW COPY (Final) Owner / Applicant PINK COPY (Initial) Owner / Applicant