Site address: 107 Maxfli Drive

IREDELL COUNTY HEALTH DEPARTMENT

STATESVILLE 704-878-5305 (c) MOORESVILLE 704-664-5281

IMPROVEMENT PERMIT / AUTHORIZATION TO CONSTRUCT / OPERATION PERMIT / EXISTING SYSTEM INSPECTION

PERMIT# 134618 PIN# 3793538893 DATE 2-10-06

OWNER OR APPLICANT Crossland Homes PHONE: Business 704-483-3702 Home

ADDRESS 5412 E Hwy 150

LOCATION I-40 W (R) Shelton School Rd (L) Mocksville Rd (R) 1st Fairway and Maxfli

SUBDIVISION August A Groves LOT / SECTION II LOT 63 LOT AREA .836 SITE CLASS B DESIGN FLOW 360 L.T.A.R. .3

Septic Tank: 1000 Gallons; STB 55 Date 4-24-06

Pump Tank: Gallons; PT Date

Pump Make: Model Serial No.

Nitrification Field: No Fields Square Feet 1200 Linear Feet 300

No Lines 4 Trench Width 36" Max Trench Bottom Depth 24"

☑ New System ☐ Repair ☐ Expansion System Type: I II III IV V VI

System Description: 25% Reduction Gravity

Repair System Description: 50%

Maintenance Agreement Required: ☐ Yes ☑ No

☑ House/Mod. Home No. Bedrooms 3

☐ Mobile Home No. Persons

☐ Business No. Employees

☐ Other


Water Supply: ☐ Individual ☐ Public ☐ Community

Gravel Depth NA ☑ Gravity ☐ Pressure ☐ Slab ☐ Crawl Space ☐ Basement w/plumbing ☐ Basement wo/plumbing


Comments:/Conditions:

Maintain all setbacks
Installer Contact

INITIAL SITE SKETCH

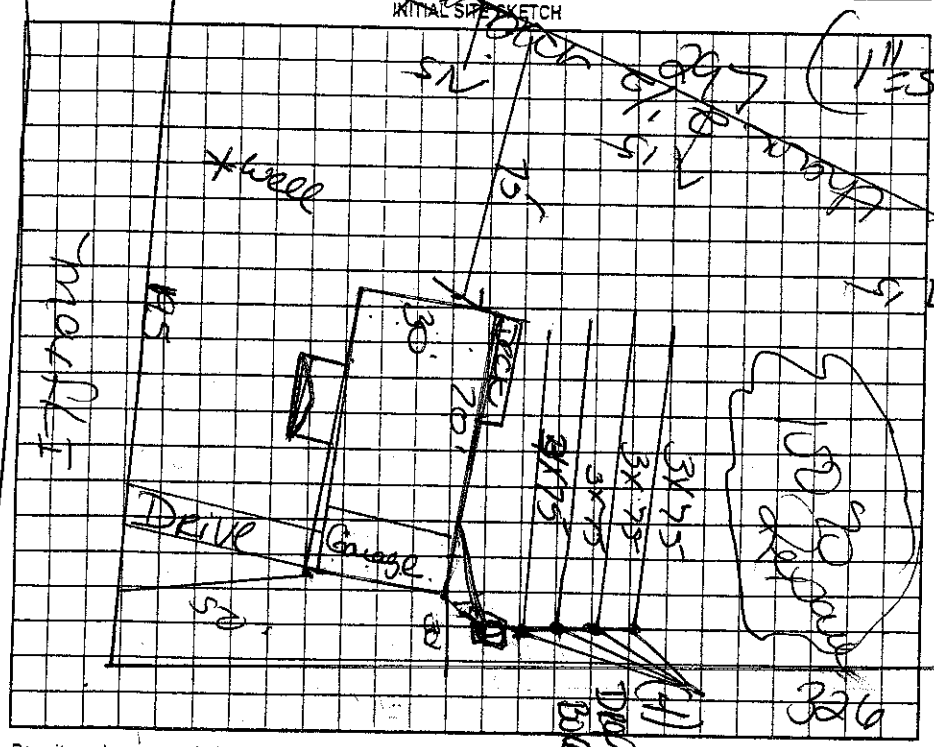

AS BUILT SKETCH

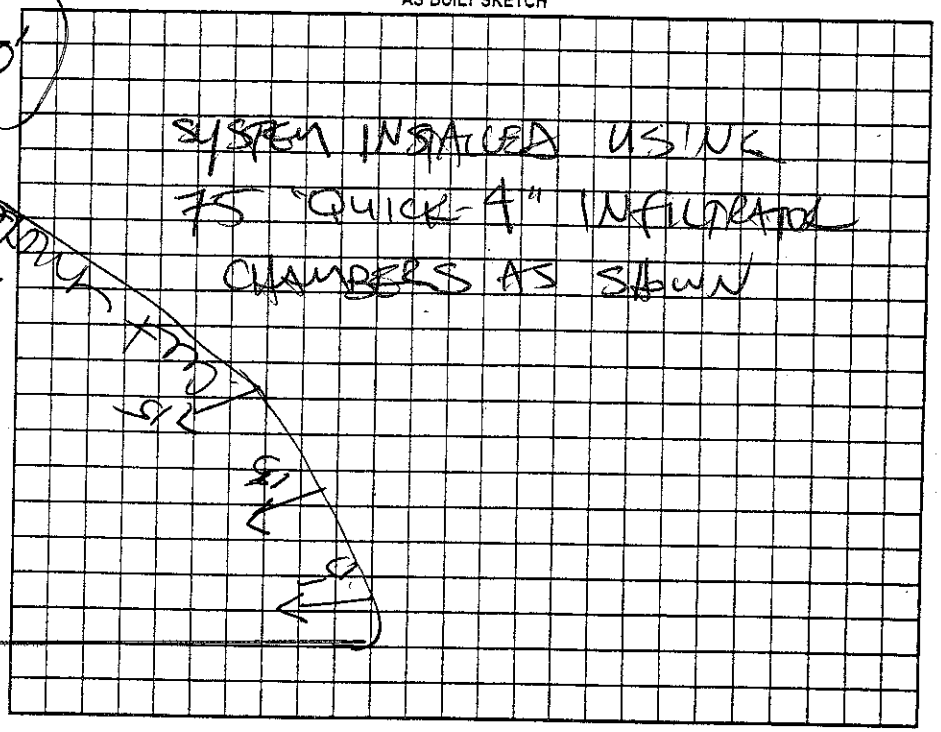

Permit can be suspended or revoked if any false information is supplied toward securing the permit/any unauthorized changes are made to the site/any unauthorized changes are made in the installation of the system. Improvement Permit with plat valid without expiration ☐ Improvement Permit with site plan valid for sixty months ☐ Authorization to Construct is valid for a period equal to that of Improvement Permit – not to exceed sixty months.

Signed: Tim Woodruff date 4-17-06 Installed by: G & M Enterprises

Improvement Permit by: Kelly Cox date 4-11-06 Operation Permit by: Steve Hedrick date 6-22-06

Authorization to Construct by: Kelly Cox date 4-11-06 Existing System Inspection by: date

HEALTH DEPT. COPY: WHITE OWNER COPY (FINAL): YELLOW OWNER COPY (INITIAL): PINK