IREDELL COUNTY HEALTH DEPARTMENT

Statesville Office (704) 878-5305 Mooresville Office (704) 660-3625 PERMIT # 179471

IMPROVEMENT PERMIT / AUTHORIZATION TO CONSTRUCT / OPERATION PERMIT / EXISTING SYSTEM

PIN # 3793539520

APPLICANT: Key Builders INC APPLICANT ADDRESS: 2125 E. Main Lincolnton NC

SITE ADDRESS: 127 Maxfli Dr. PHONE: 704-466-8423 ALT. PHONE: N/A

SITE DIRECTIONS: ~~Hwy~~ I-40W to Sharon School TL on Sharon School TL Mock Mill JR Titleist TR Maxfli


SUBDIVISION: Augusta Greens SECTION: N/A LOT # 60 LOT AREA: 1.032 acres DESIGN FLOW: 480 gpd L.T.A.R.: 0.25

Septic Tank	1000 (gal)	STB 1000-735	Date 7-13	☑ New System	☐ Repair	☐ Expansion	System Type: I II III IV V VI	☑ Residence	No. Bedrooms	4	Water Supply
Pump Tank	(gal)	PT	Date	System Description:	25% Reduction			☐ Business	No. Persons		☐ Private
Pump Make	Model		Serial #	Repair System Description:	25% Reduction			☐ Other	No. Employees		☑ Public
# Nitrification Fields	1	# Lines 6	Linear Ft: 480	Maintenance Agreement Required:	☐ YES	☐ NO		☐ Slab	☑ Crawl Space		☐ Community
Trench Width	36"	Max. Trench Bottom Depth	36"	Gravel Depth	N/A	☐ GRAVITY	☐ PRESSURE	☐ Basement w/plumbing			☐ Basement w/o plumbing


Comments / Conditions: Improvements ONLY! Submit floor plan prior to issuance of CA. Install a 25% Reduction system on contour with Serial distribution.

CA issued 7-31-13

INITIAL SITE SKETCH

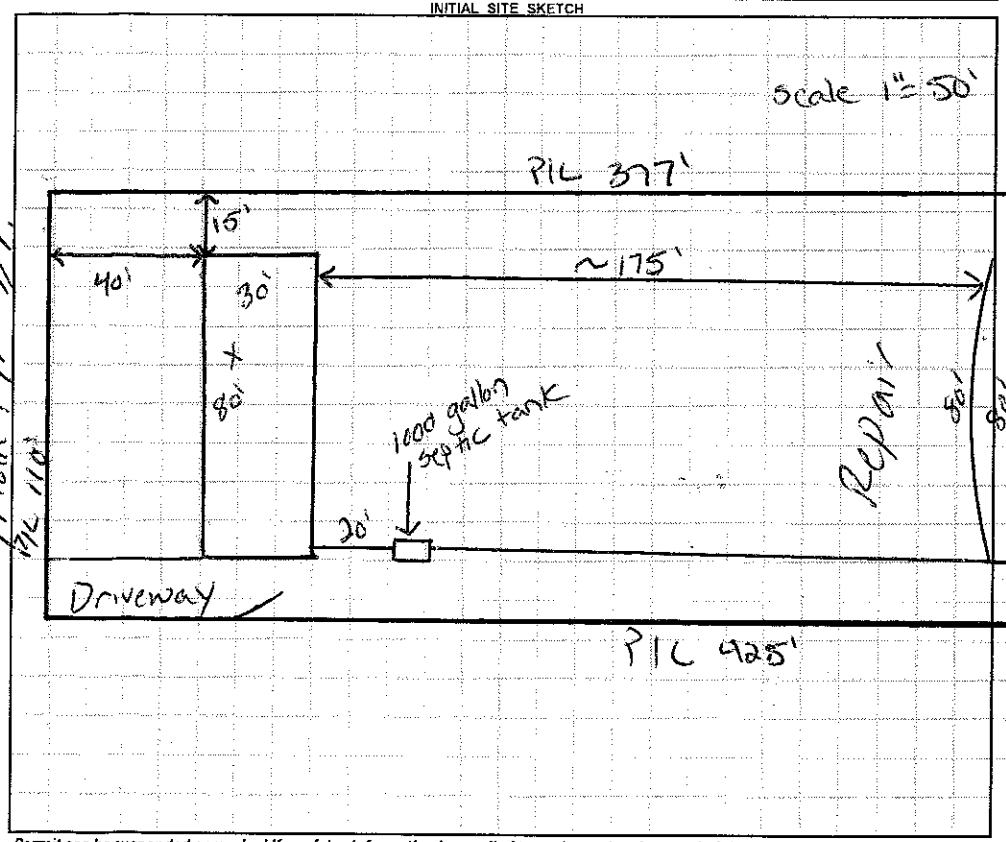

AS BUILT SKETCH

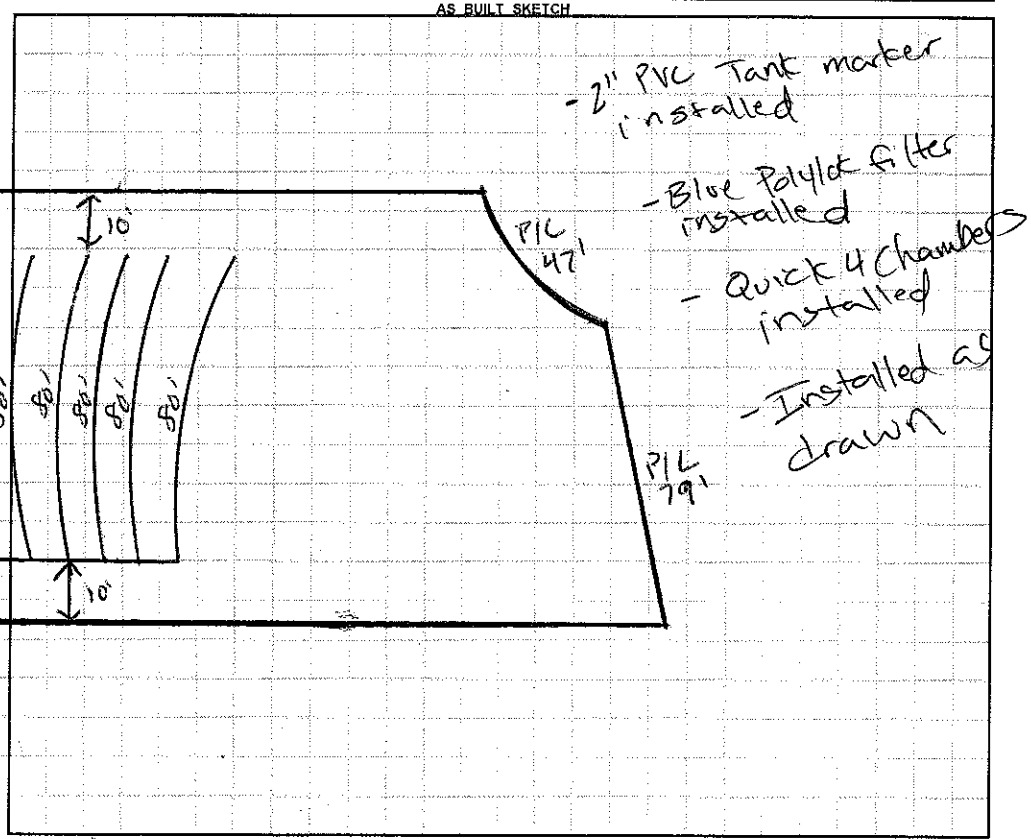

Maxfli Dr. 1/2

Permit can be suspended or revoked if any false information is supplied toward securing the permit / any unauthorized changes are made to the site / any unauthorized changes are made in the installation of the system. **CONTACT A LOCATOR SERVICE PRIOR TO ANY EXCAVATION**

☐ **IMPROVEMENT PERMIT** *with plat valid without expiration.* ☑ **IMPROVEMENT PERMIT** *with site plan valid for 60 mos.* ☑ **AUTHORIZATION TO CONSTRUCT** *valid for period equal to IMPROVEMENT PERMIT--not to exceed 60 mo.*

Owner / Applicant Signature: [signature] Date: 7-31-13 Installed by: Stanly Burns

IMPROVEMENT PERMIT by: Justin Henderson Date: 7-30 13 OPERATION PERMIT by: Justin Henderson Date: 10-10-13

AUTHORIZATION TO CONSTRUCT by: Justin Henderson Date: 7-31-13 Existing System Inspected by: Date:

Health Dept. Copy - WHITE Applicant (Final Approval) - YELLOW Applicant (Conditional Approval) - PINK