IREDELL COUNTY HEALTH DEPARTMENT - *ENVIRONMENTAL HEALTH* ☒ STATESVILLE OFFICE 704-878-5305 ☐ MOORESVILLE OFFICE 704-664-5281

IMPROVEMENT PERMIT / AUTHORIZATION TO CONSTRUCT (1) / OPERATION PERMIT (1) / EXISTING SYSTEM INSPECTION

PERMIT # 163807 PIN # 3793-54-5958 DATE 11-12-10

OWNER Garrett Belcher APPLICANT: PHONE: Home/Cell # ~~304-228-5213~~ Business # 704-775-5266

SITE ADDRESS 105 Top Flite Dr. OWNER / APPLICANT ADDRESS 144 Bluegrass Circle. Mooresville, NC

SITE DIRECTIONS Sharon School Rd to Mock Mill Rd., (R) Titleist, (R) on Top Flite

SUBDIVISION Augusta Greens BLOCK / SECTION LOT # 21 LOT AREA .674 DESIGN FLOW 360 L.T.A.R. .3

Septic Tank 1000 Gallons: STB 825 Date 11-9-10
Pump Tank ____ Gallons: P T ____ Date ____
Pump Make ____ Model ____ Serial # ____
No. Nitrification Fields: 1 No. Lines 3 Linear Feet 300
Trench Width 36" Max. Trench Bottom Depth 36" Gravel Depth n/a

☒ New System ☐ Repair ☐ Expansion System Type I II (III) IV V VI
System Description: 25% Reduction Gravity
Repair System Description: 25% Reduction Gravity
Maintenance Agreement Required ☐ YES ☒ NO
☒ GRAVITY ☐ PRESSURE

☒ Residence No. Bedrooms 3
☐ Business No. Persons ____
☐ Other No. Employees ____
☐ Slab ☒ Crawl Space
☐ Basement w/plumbing ☐ Basement w/o plumbing


Water Supply: ☐ Private ☒ Public ☐ Community

Comments / Conditions


1" = 50' * Called 2-11-11 End Cap Distribution approved.

SEPTIC TANK WITH MARKER INSTALLED USING "POLYLOK" FILTER (BLUE)

INITIAL SITE SKETCH

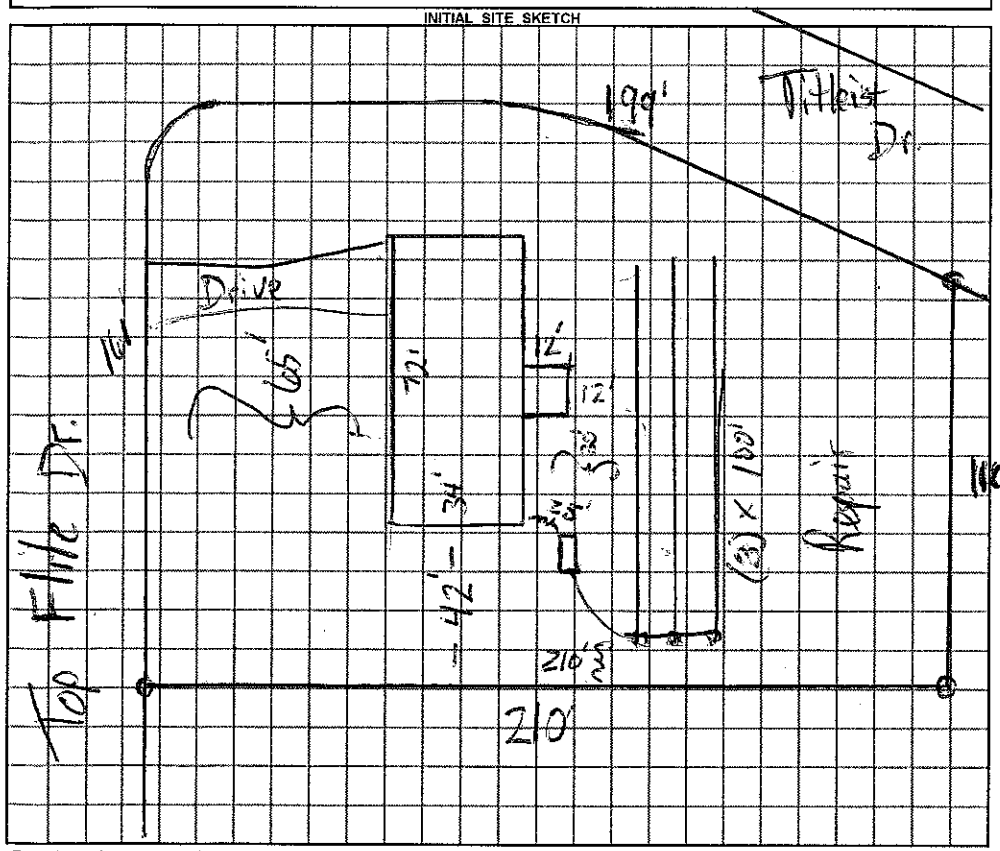

AS BUILT SKETCH

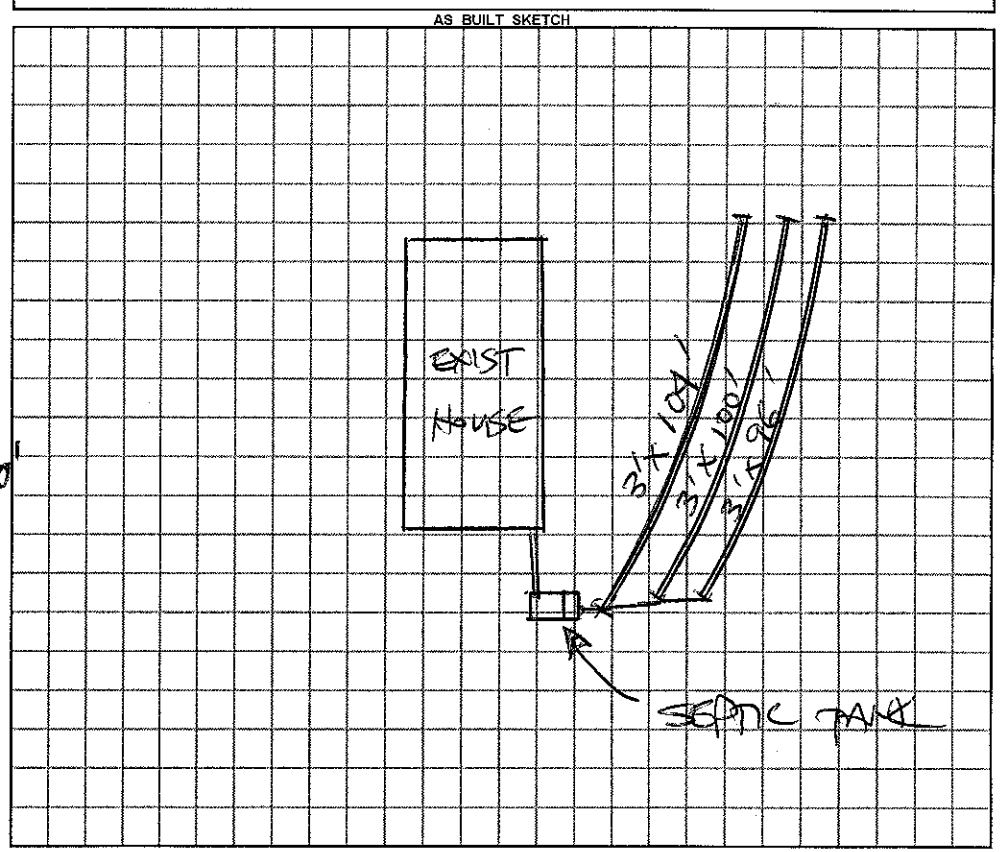

Permit can be suspended or revoked if any false information is supplied toward securing the permit / any unauthorized changes are made to the site / any unauthorized changes are made in the installation of the system.

☐ ***IMPROVEMENT PERMIT*** with plat valid without expiration. ☒ ***IMPROVEMENT PERMIT*** with plat valid without expiration. ☒ ***AUTHORIZATION TO CONSTRUCT*** valid for period equal to IMPROVEMENT PERMIT--not to exceed 60 mo.

Owner / Applicant Signature: Kim Belcher Date 11/12/10 Installed by: ROWAN SEPTIC TANK

IMPROVEMENT PERMIT by: James [illegible] REHS Date 11-12-10 OPERATION PERMIT by: STEVE HEDRICK REHS Date 2-14-11

AUTHORIZATION TO CONSTRUCT by: Carol [illegible] REHS Date 11-12-10 Existing System Inspected by: ____ REHS Date ____

YOU SHOULD CONTACT A LOCATOR SERVICE PRIOR TO ANY EXCAVATION

White Copy – Environmental Health YELLOW COPY (Final) Owner / Applicant PINK COPY (Initial) Owner / Applicant