IREDELL COUNTY HEALTH DEPARTMENT

Statesville Office (704) 878-5305 Mooresville Office (704) 660-3625 PERMIT # 211237

IMPROVEMENT PERMIT / AUTHORIZATION TO CONSTRUCT / OPERATION PERMIT / EXISTING SYSTEM

PIN # 3793550101

APPLICANT: Christopher Boger APPLICANT ADDRESS: 132 Top Flite Dr.

SITE ADDRESS: 132 Top Flite Dr. PHONE: 704-557-6450 ALT. PHONE: N/A

SITE DIRECTIONS: I-40W to Sharon School Rd. TL Sharon School TL Mock Mill TR Tit

SUBDIVISION: Augusta Greens SECTION: P2 LOT # [redacted]12 LOT AREA: 0.568 acres DESIGN FLOW: 360gpd L.T.A.R.: Existing

Septic Tank Existing (gal) STB Date

Pump Tank (gal) PT Date

Pump Make Model Serial #

Nitrification Fields Ex # Lines Ex Linear Ft: Ex

Trench Width Ex Max. Trench Bottom Depth Ex Gravel Depth Ex

☐ New System ☐ Repair ☐ Expansion System Type: I II (III) IV V VI

System Description: Existing

Repair System Description:

Maintenance Agreement Required: ☐ YES ☑ NO

☑ GRAVITY ☐ PRESSURE

☑ Residence No. Bedrooms 3

☐ Business No. Persons 6

☐ Other No. Employees

☐ Slab ☑ Crawl Space


☐ Basement w/plumbing ☐ Basement w/o plumbing

Water Supply: ☐ Private ☑ Public ☐ Community


Comments / Conditions:

- Maintain a minimum of 5' between Garage foundation & all components of septic tank system.

INITIAL SITE SKETCH

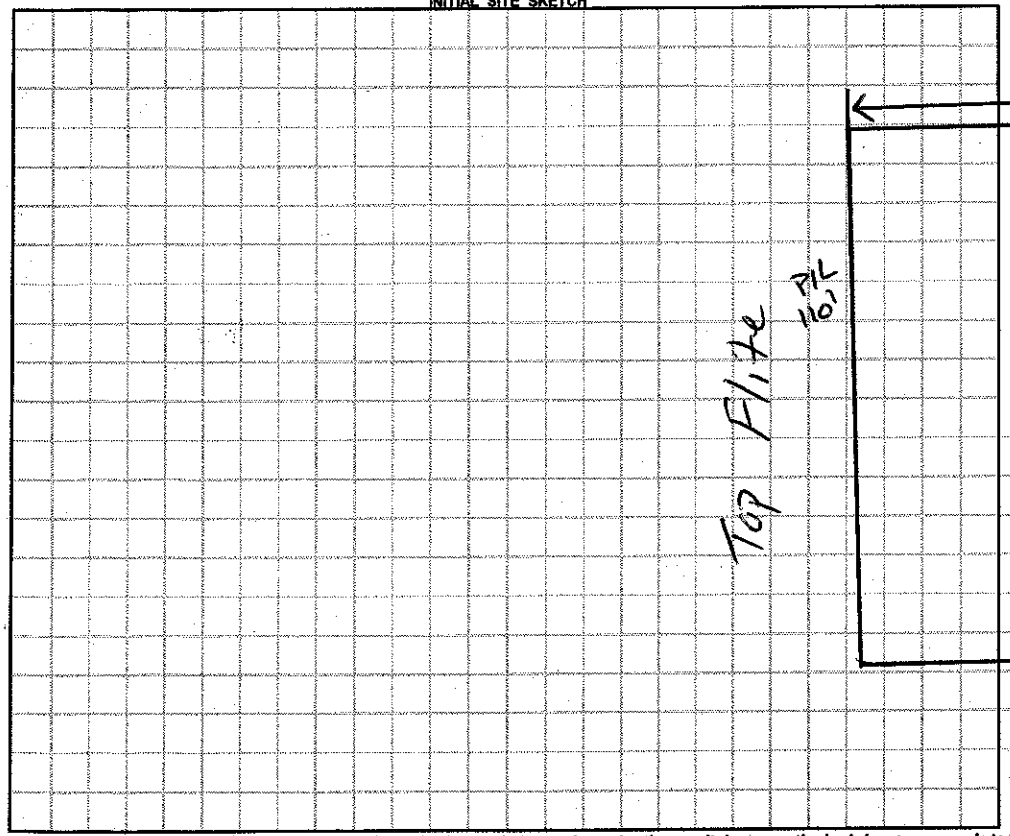

AS BUILT SKETCH

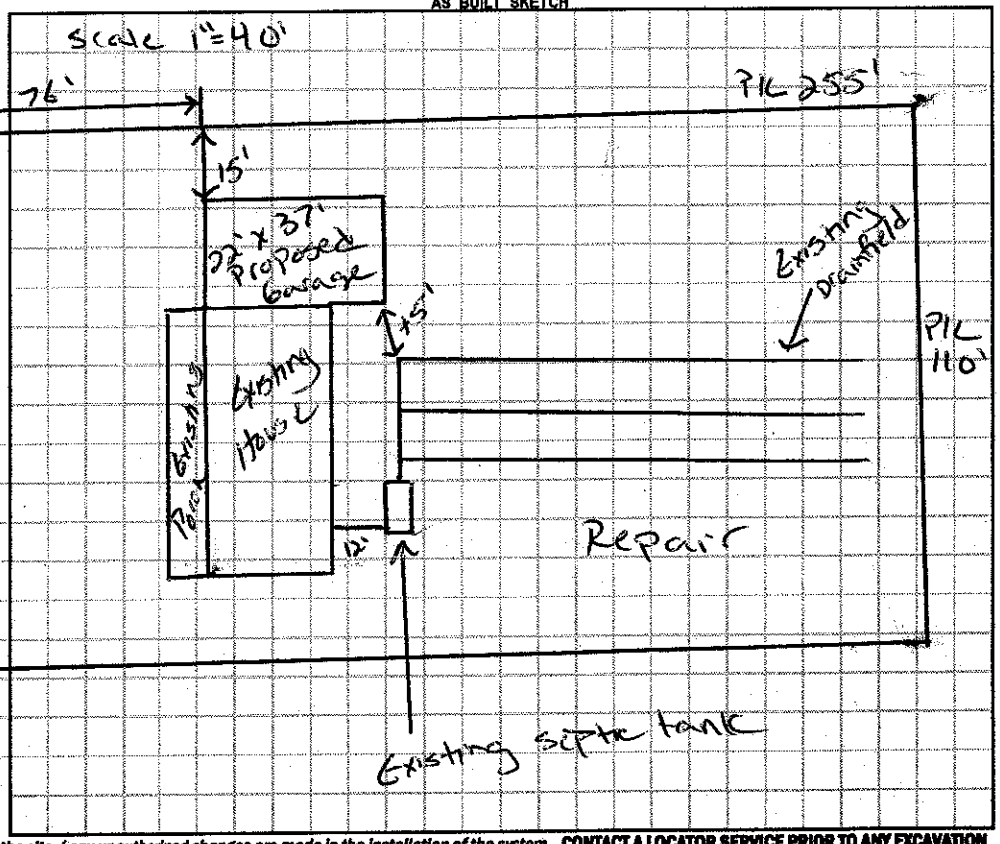

Permit can be suspended or revoked if any false information is supplied toward securing the permit / any unauthorized changes are made to the site / any unauthorized changes are made in the installation of the system. **CONTACT A LOCATOR SERVICE PRIOR TO ANY EXCAVATION**


☐ **IMPROVEMENT PERMIT** *with plat valid without expiration* ☐ **IMPROVEMENT PERMIT** *with site plan valid for 60 mos.* ☐ **AUTHORIZATION TO CONSTRUCT** *valid for period equal to IMPROVEMENT PERMIT--not to exceed 60 mo.*

Owner / Applicant Signature: Date: Installed by:

IMPROVEMENT PERMIT by: Date: OPERATION PERMIT by: Date:

AUTHORIZATION TO CONSTRUCT by: Date: Existing System Inspected by: Date: 6-29-15

Health Dept. Copy - WHITE Applicant (Final Approval) - YELLOW Applicant (Conditional Approval) - PINK

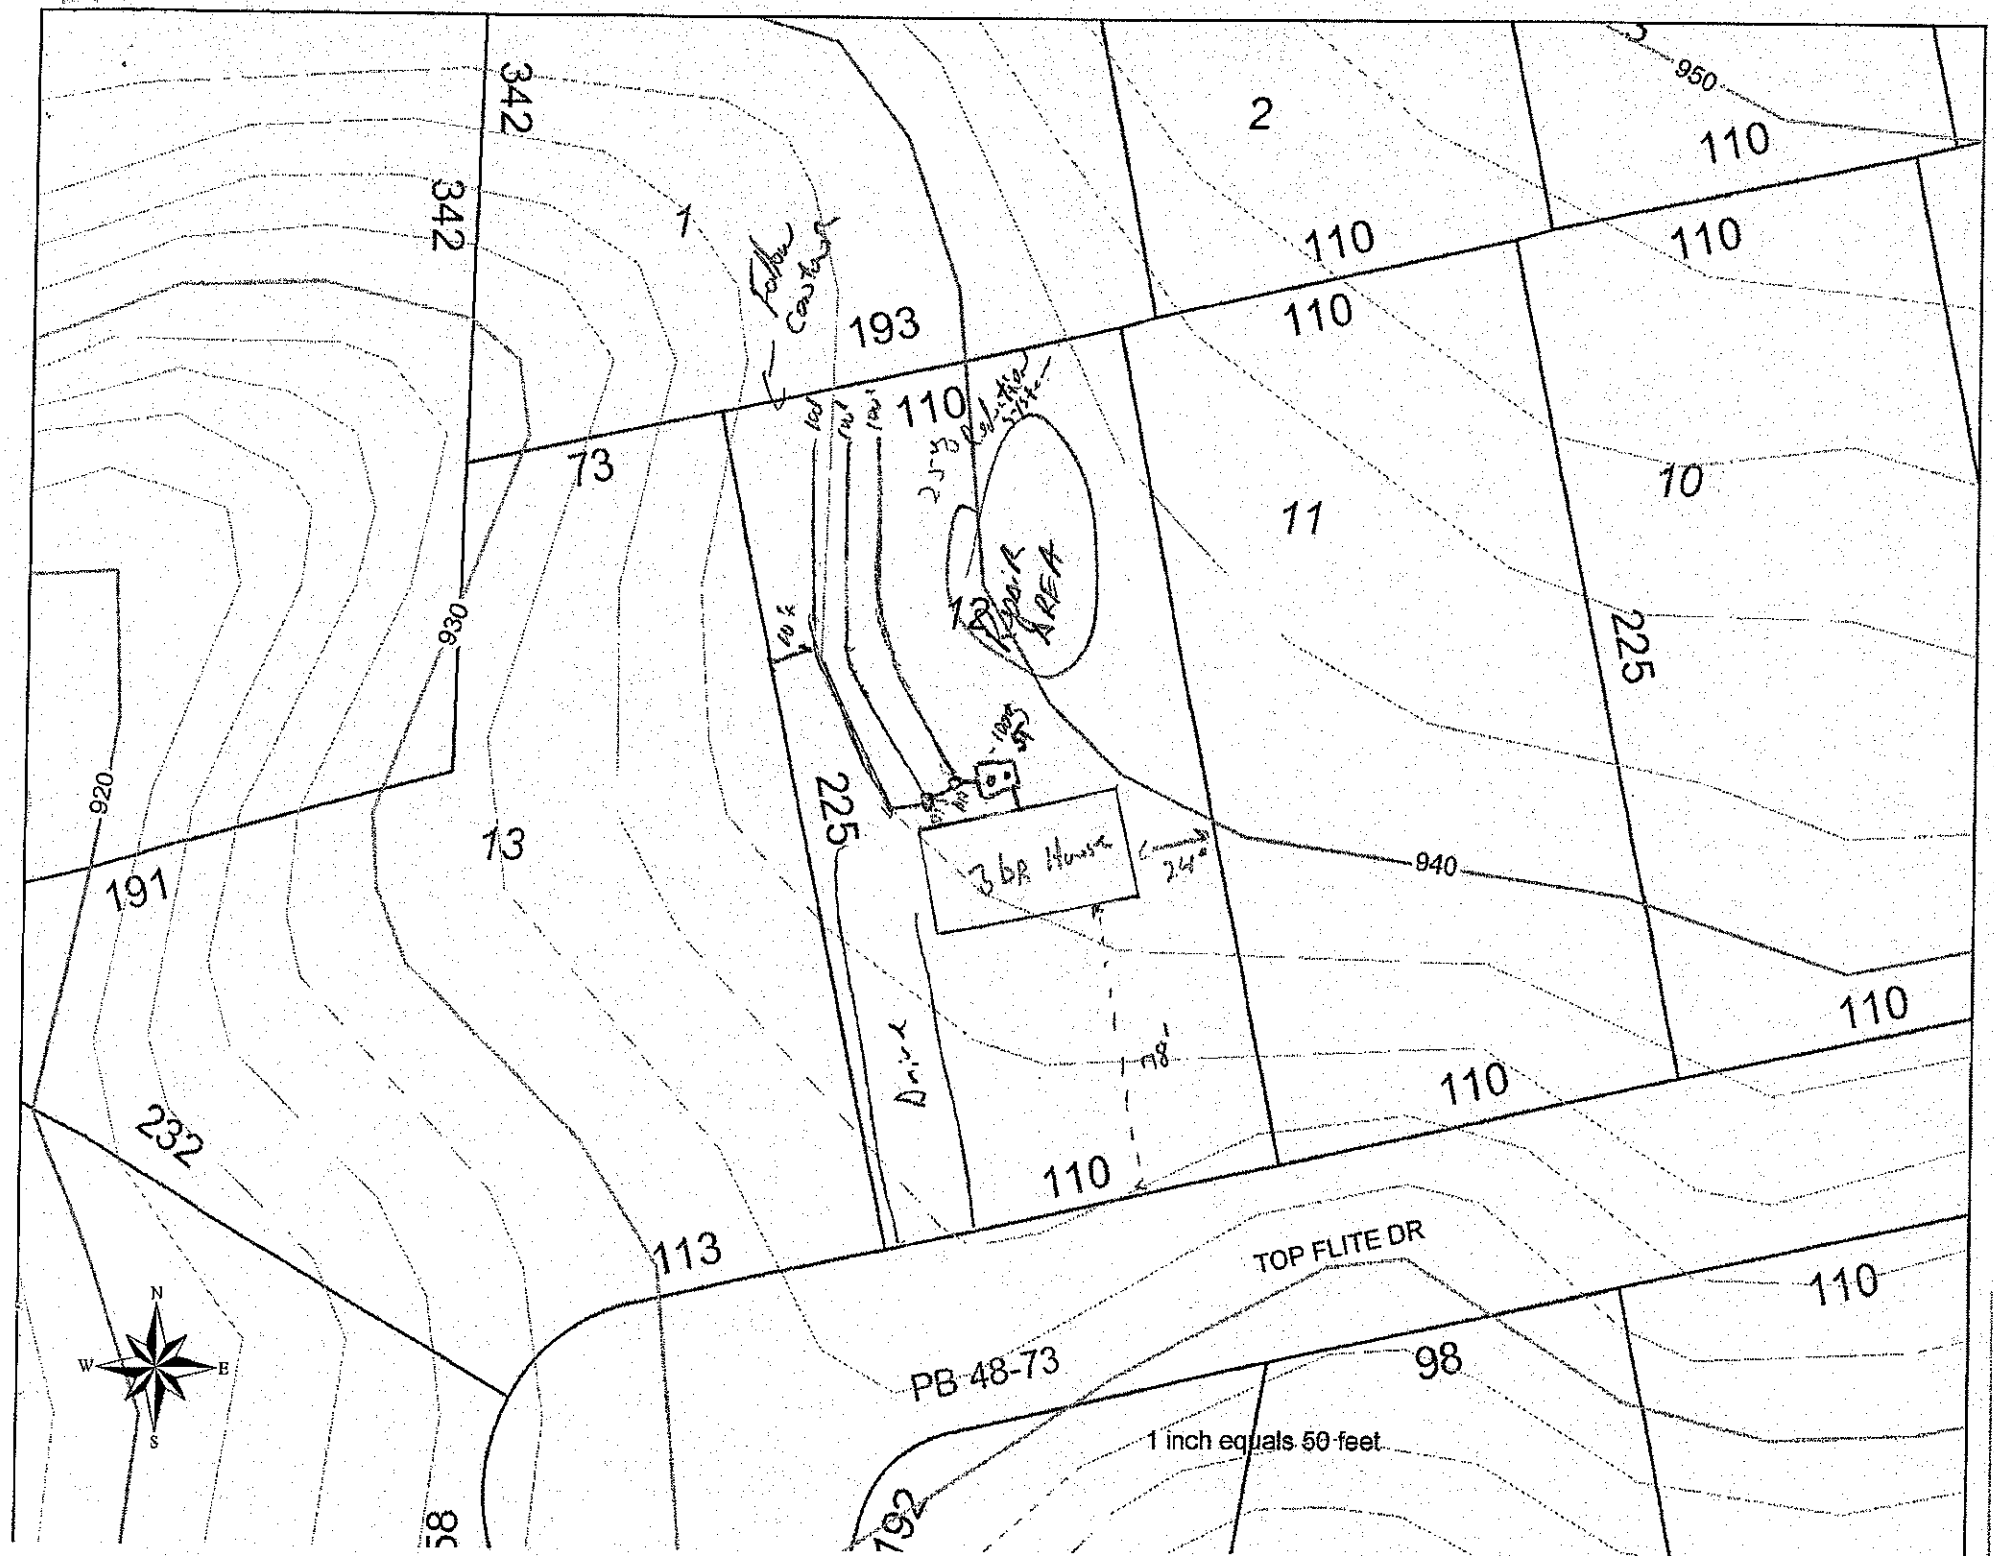
342
342
1
Pulled Contours
193
2
950
110
110
110
110
110
73
930
920
191
13
225
225
10
11
12
Repair Area
3 bR House
24'
940
110
110
110
110
232
113
Drive
18'
TOP FLITE DR
PB 48-73
98
192
N
W
E
S
1 inch equals 50 feet