IREDELL COUNTY HEALTH DEPARTMENT

STATESVILLE 704-878-5305 MOORESVILLE 704-664-5281

IMPROVEMENT PERMIT / AUTHORIZATION TO CONSTRUCT / OPERATION PERMIT / EXISTING SYSTEM INSPECTION

PERMIT# 18529 PIN# 3793-55-3472 DATE 2-13-06

OWNER OR CONTRACTOR JOHNNY LOWE PHONE: Business _____ Home 704-534-4700

ADDRESS 130 LAZY LANE MOORESVILLE NC 28117

LOCATION I-40 (E) SHARON SCHOOL (L) MOCKSVILLE CHURCH IN FRONT OF UNITY BAPTIST CHURCH

SUBDIVISION AUGUSTA ESTATES BLOCK / SECTION _____ LOT 5 LOT AREA 1.646 SITE CLASS. PS DESIGN FLOW 480 L.T.A.R. .3

Septic Tank: 1000 Gallons; STB 1017 Date 3-17-06

Pump Tank: _____ Gallons; PT _____ Date _____

Pump Make: _____ Model _____ Serial No. _____

Nitrification Field: No Fields 1 Square Feet 1600 Linear Feet 400'

No Lines 4 Trench Width 36" Max Trench Bottom Depth 36" Gravel Depth N/A

X New System ☐ Repair System Type: I, II, III, IV, V, VI

System Description: 60% 75% REDUCTION

Repair System Description: LP 35% REDUCTION

Maintenance Agreement Required: ☐ Yes X No

X House/Mod. Home No. Bedrooms 4

☐ Mobile Home No. Bathrooms 3

☐ Business No. Employees _____


☐ Other _____

☐ Slab ☐ Crawl Space ☐ Basement w/plumbing X Basement wo/plumbing


Water Supply: ☐ Individual X Public ☐ Community

Comments:/Conditions: (1) WELL IN BACKYARD ABANDONED PROPERLY BY ATTACHED PAPERWORK (2) LESS THAN 20% SLOPE NO NEED TO FOLLOW CONTOURS (3) THIS IS AN EXISTING REMODELED HOME; (4) OLD SEPTIC RUN OUT ON TOP OF GROUND (5) SMALL LOT IS SD FLAT USE DIST. BOX ON EACH LINE WITH SPEED LEVELER TURNED AT 3rd AS A SMALLER DROP BOX.

INITIAL SITE SKETCH NOT TO SCALE

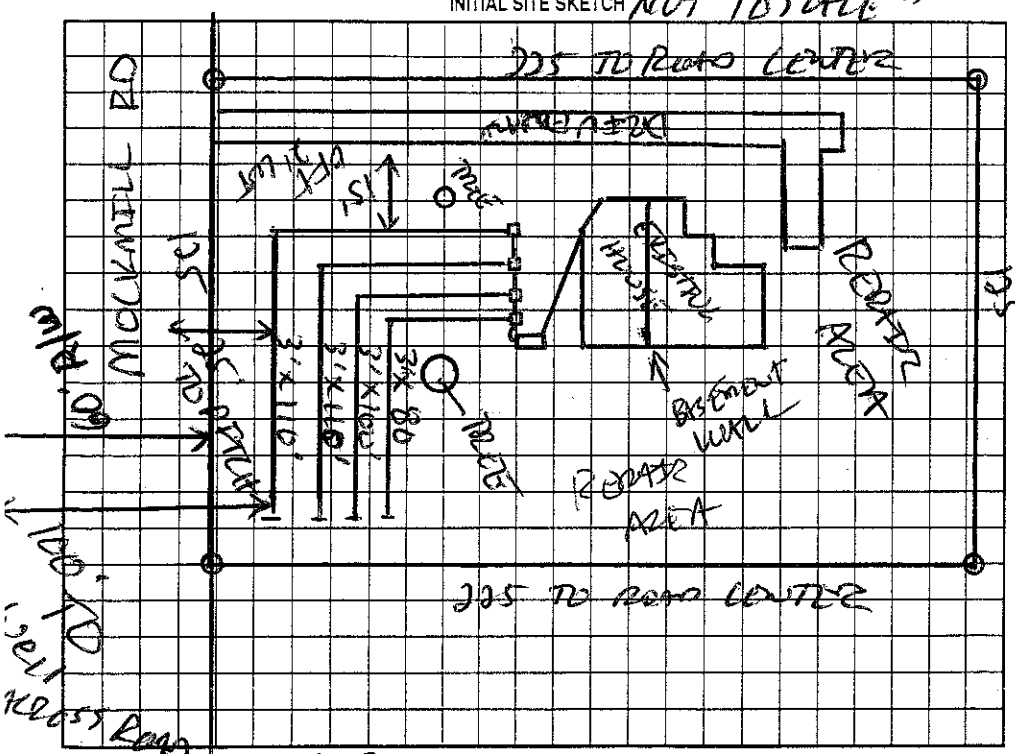

AS BUILT SKETCH

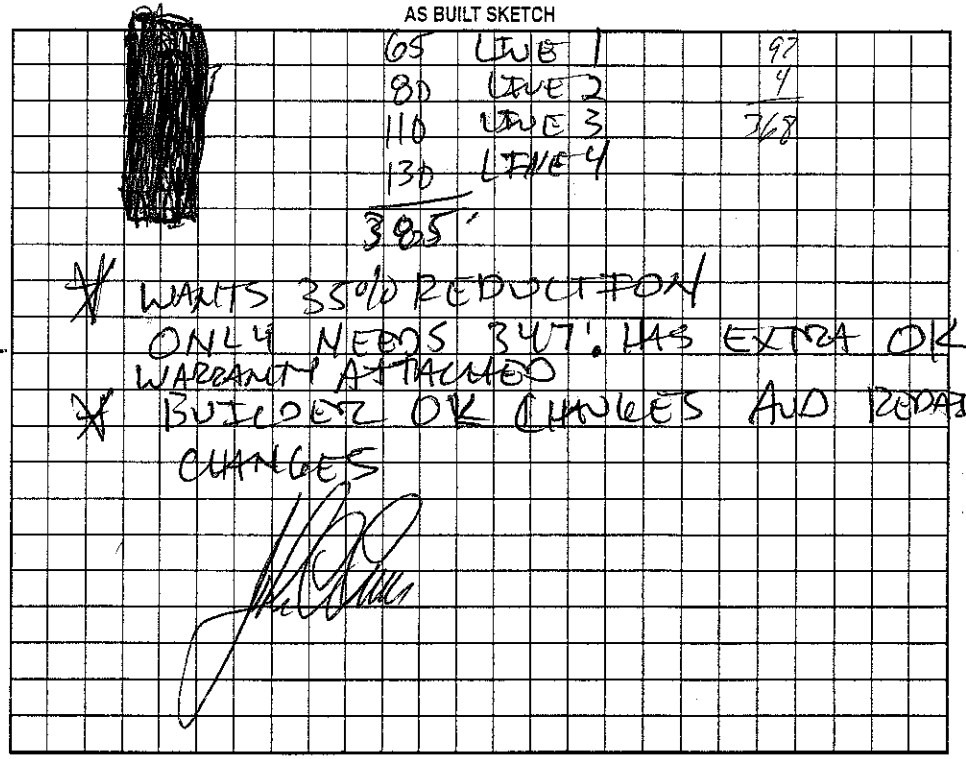

Permit can be suspended or revoked if any false information is supplied toward securing the permit/any unauthorized changes are made to the site/any unauthorized changes are made in the installation of the system. Improvement Permit with plat valid without expiration. Improvement Permit with site plan valid for sixty months. Authorization to Construct is valid for a period equal to that of Improvement Permit – not to exceed sixty months.

Signed: _____ date 2-21-06 Installed by: A-1 BACKHOE

Improvement Permit by: _____ date 2-13-06 Operation Permit by: _____ date 9-28-06

Authorization to Construct by: _____ date 2-13-06 Existing System Inspection by: _____ date _____

HEALTH DEPT. COPY: WHITE OWNER COPY (FINAL): YELLOW OWNER COPY (INITIAL): PINK