IREDELL COUNTY HEALTH DEPARTMENT

STATESVILLE 704-878-5305 MOORESVILLE 704-664-5281

IMPROVEMENT PERMIT / AUTHORIZATION TO CONSTRUCT / OPERATION PERMIT / EXISTING SYSTEM INSPECTION

PERMIT# 12857 PIN# 3793-55-4485 DATE 7/2/05

OWNER OR CONTRACTOR JOHN CRAVER PHONE: Business 704-534-4700 Home 704-663-2270

ADDRESS 130 LAZY LANE MOORESVILLE, NC 28117

LOCATION 40 WEST ON SHARON ON MOLLY HILL 1 mile on RT AT LOT # 6

SUBDIVISION AUGUSTA GREENS BLOCK / SECTION I LOT 6 LOT AREA .566 SITE CLASS PS DESIGN FLOW 480 L.T.A.R. .13

Septic Tank: 1000 Gallons; STB 1012 Date 7-8-05
Pump Tank: _____ Gallons; PT _____ Date _____
Pump Make: _____ Model _____ Serial No. _____
Nitrification Field: No Fields 1 Square Feet EXT=1600' Linear Feet 400'
No Lines 5x80' Trench Width 36" Max Trench Bottom Depth 24" Gravel Depth N/A

☒ New System ☐ Repair System Type: I, II, III, IV, V, VI
System Description: 6 BAY 25% REDUCT
Repair System Description: LP 50% 1000 LF
Maintenance Agreement Required: ☐ Yes ☒ No

☒ House/Mod. Home No. Bedrooms 4
☐ Mobile Home No. Bathrooms 3
☐ Business No. Employees ____
☐ Other _____
☐ Slab ☑ Crawl Space ☐ Basement w/plumbing ☐ Basement wo/plumbing

Water Supply: ☐ Individual ☒ Public ☐ Community

Comments:/Conditions: ① ROAD NOT CUT IN AT TIME OF CHECK. MAINTAIN SETBACKS OR PERMIT WILL BE VOID. ② 1 SPOT WAS 12% SLOPE, LOOSE 5" totaling TB of 19" ON THE SLOW SIDE. DUE TO THIS BE CAREFUL DURING DIGGING.

Comments:/Conditions: ③ LSS SUBMITTED PLAT SHOWING ABANDONED WELL 60' FROM 1ST REPAIR LINE UPSLOPE. Will later submit well abandonment, but well is abandoned. ✱ SETBACK IS MAINTAINED ✱ TO FITTIE FILTER ENCLOSURE


INITIAL SITE SKETCH

INSTALL SYSTEM ACCORDING TO LSS SPECIFICATIONS SUBMITTED BY MIKE ATKINTES. LSS

AS BUILT SKETCH

Approved 56'x30' PLAN, MAINTAIN SETBACKS 7-12-05

WELL IS 50' OFF REPAIR 2" WELL CASED

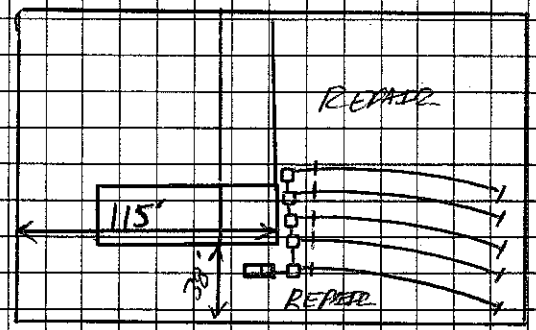

④ SYSTEM SLID UP HILL 18' FLIP FLOPPING FIRST TWO LINES OF REPAIR TO THE BOTTOM ↓ TANK MOVED BEHIND THE GARAGE. INSTALLED INFILTRATOR CHAMBERS ↓ ROAD NOT CUT IN AT TIME OF CHECK. MAINTAIN SETBACKS. CONTRACTOR AUTHORIZES CHANGES. ✱

Permit can be suspended or revoked if any false information is supplied toward securing the permit/any unauthorized changes are made to the site/any unauthorized changes are made in the installation of the system. Improvement Permit with plat valid without expiration. Improvement Permit with site plan valid for sixty months. Authorization to Construct is valid for a period equal to that of Improvement Permit – not to exceed sixty months.

Signed: Tina Johnston date 7-12-05 Installed by: A-1 BACKHOE

Improvement Permit by: [signature] date 7/12/05 Operation Permit by: [signature] date 7/13/05

Authorization to Construct by: [signature] date 7/12/05 Existing System Inspection by: _____ date _____

HEALTH DEPT. COPY: WHITE OWNER COPY (FINAL): YELLOW OWNER COPY (INITIAL): PINK