IREDELL COUNTY HEALTH DEPARTMENT

STATESVILLE 704-878-5305 MOORESVILLE 704-664-5281

IMPROVEMENT PERMIT / AUTHORIZATION TO CONSTRUCT / OPERATION PERMIT / EXISTING SYSTEM INSPECTION

PERMIT# 128527 PIN# 3793-55-4485 DATE 7/2/05

OWNER OR CONTRACTOR JOHN CONDE PHONE: Business 704-534-4700 Home 704-663-2250

ADDRESS 180 IAZY LANE MOORESVILLE, NC 28117

LOCATION 40 WEST ON SIPRON ON MOUNTAIL 1 mile on Rt AT LOT # 6

SUBDIVISION AUGUSTA ACRES BLOCK / SECTION LOT 6 LOT AREA 1.566 SITE CLASS PS DESIGN FLOW 480 L.T.A.R. 13

Septic Tank: 1000 Gallons; STB 1012 Date 7-18-05
Pump Tank: Gallons; PT Date
Pump Make: Model Serial No
Nitrification Field: No Fields 1 Square Feet 8@=160' Linear Feet 400'
No Lines 5x80' Trench Width 36" Max Trench Bottom Depth 24"

[X] New System [ ] Repair System Type: [ ] I, II, III, IV, V
System Description: 600-1 25% RED
Repair System Description: LPP 50% REDUCT
Maintenance Agreement Required: [ ] Yes [X] No

[X] House/Mod. Home No. Bedrooms 4
[ ] Mobile Home No. Bathrooms 3
[ ] Business No. Employees
[ ] Other


Gravel Depth n/a [ ] Slab [X] Crawl Space [ ] Basement w/plumbing [ ] Basement w/o plumbing

Water Supply: [ ] Individual [X] Public [ ] Community


Comments/Conditions: ① ROAD NOT CUT IN AT TIME OF CHECK. MAINTAIN SETBACKS OR PERMIT WILL BE VOID. ② 1 SPOT WAS 12% SLOPE, LOOSE 5" TOLERANCE TO OF 19" ON THE BLOW SIDE. DUE TO THIS BE CAREFUL DURING DISTURB.

Comments/Conditions: ③ LSS SUBMITTED PLAT SHOWING ABANDONED WELL 60' FROM 1ST TRENCH UPSLOPE. WILL later SUBMIT WELL DISMANTLEMENT, but WELL is abandoned. *SETBACK IS MAINTAINED* TO FUTURE PROPERTY LINE

INITIAL SITE SKETCH

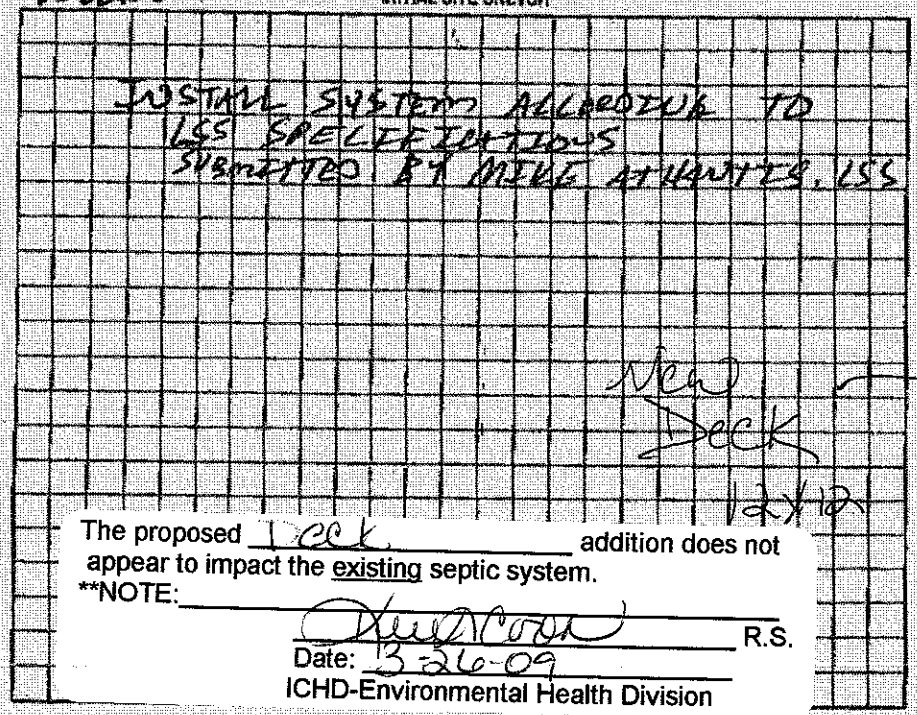

AS BUILT SKETCH

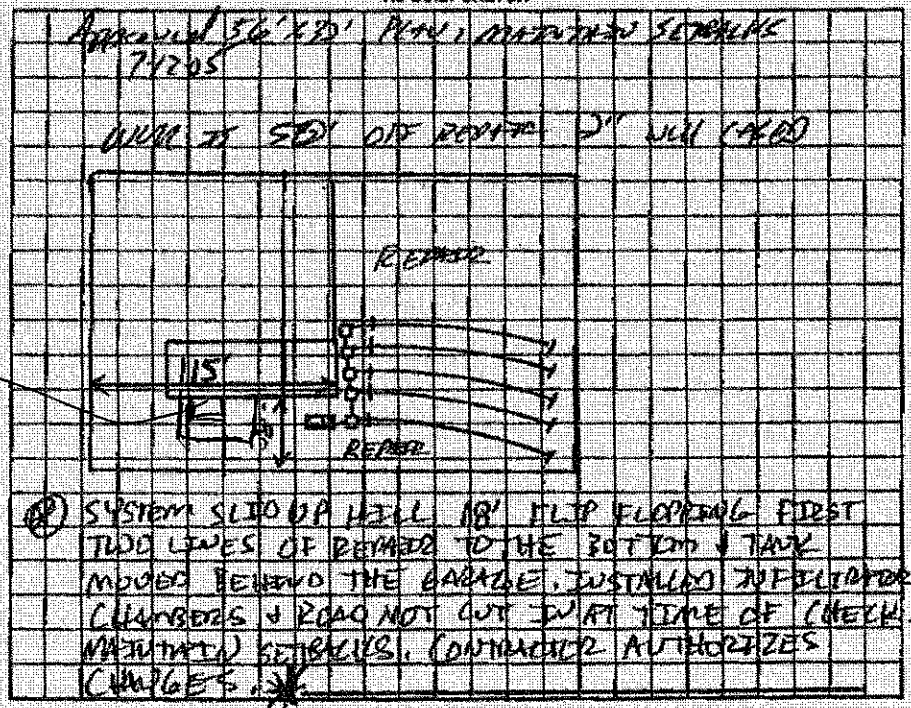

The proposed Deck addition does not appear to impact the existing septic system.
**NOTE:
R.S.
Date: 3-26-09
ICHD-Environmental Health Division

Permit can be suspended or revoked if any false information is supplied toward securing the permit/any unauthorized changes are made to the site/any unauthorized changes are made in the installation of the system. Improvement Permit with plat valid without expiration. Improvement Permit with site plan valid for sixty months. Authorization to Construct is valid for a period equal to that of Improvement Permit – not to exceed sixty months.

Signed: Jana Johnston date 2-12-05 Installed by: A-1 BACKHOE

Improvement Permit by: date 7-12-05 Operation Permit by: date 7-13-05

Authorization to Construct by: date 7-12-05 Existing System Inspection by: date

HEALTH DEPT. COPY: WHITE OWNER COPY (FINAL): YELLOW OWNER COPY (INITIAL): PINK