IREDELL COUNTY HEALTH DEPARTMENT

STATESVILLE 704-878-5305 MOORESVILLE 704-664-5281

IMPROVEMENT PERMIT / AUTHORIZATION TO CONSTRUCT / OPERATION PERMIT / EXISTING SYSTEM INSPECTION

PERMIT# 140942 PIN# 3793-55-5213 DATE 21 March 07

OWNER OR APPLICANT J. M. Workman Co. PHONE: Business 704-622-3996 Home

ADDRESS 452 South Main St. Davidson, N.C.

LOCATION 104 Top Flite Dr. Statesville

SUBDIVISION Augusta Grove BLOCK / SECTION 2 LOT 7 LOT AREA 0.644 ac. SITE CLASS. PS DESIGN FLOW 360gpd. L.T.A.R. 0.3/47%2

Septic Tank: 1000g Gallons: STB 1072 Date 4/4/07

Pump Tank: Gallons: PT Date

Pump Make: Model Serial No.

Nitrification Field: No Fields 1 Square Feet 1200 Linear Feet 300

No Lines 4 Trench Width 36" Max Trench Bottom Depth 36" Gravel Depth ☑ Gravity ☐ Pressure

☑ New System ☐ Repair ☐ Expansion System Type: I II III IV V VI

System Description: 25% Reduction

Repair System Description: 25% Reduction

Maintenance Agreement Required: ☐ Yes ☑ No

☑ House/Mod. Home ☐ Mobile Home ☐ Business ☐ Other

No. Bedrooms 3 No. Persons No. Employees

Water Supply: ☐ Individual ☑ Public ☐ Community

☐ Slab ☑ Crawl Space ☐ Basement w/plumbing ☐ Basement wo/plumbing


Comments:/Conditions: Follow contour / use 3 drop-boxes.

1" = 50'

Comments:/Conditions:

end cap dia. Yellow top tote Septic tank marker

INITIAL SITE SKETCH

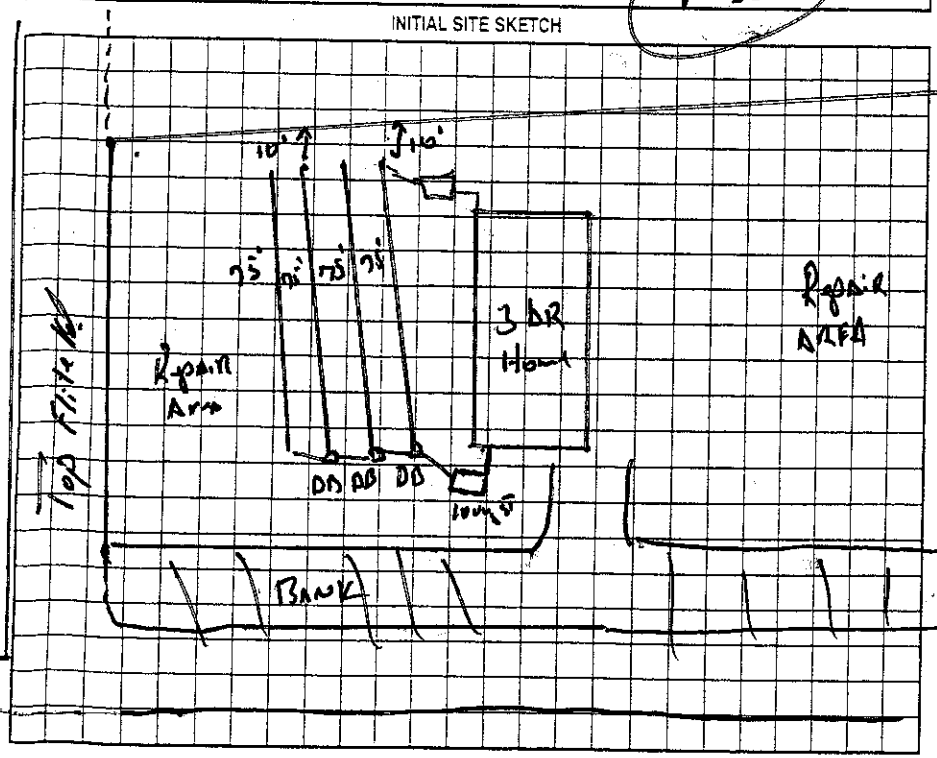

AS BUILT SKETCH

Permit can be suspended or revoked if any false information is supplied toward securing the permit/any unauthorized changes are made to the site/any unauthorized changes are made in the installation of the system. Improvement Permit with plat valid without expiration ☐ Improvement Permit with site plan valid for sixty months ☑ Authorization to Construct is valid for a period equal to that of Improvement Permit – not to exceed sixty months.

Signed: date 3-26-07 Installed by: A-1 Backhoe

Improvement Permit by: J. Hagg, R.S. date 21 March 07 Operation Permit by: Kelli Cook date 3-27-07

Authorization to Construct by: J. Hagg, R.S. date 21 March 07 Existing System Inspection by: date

HEALTH DEPT. COPY: WHITE OWNER COPY (FINAL): YELLOW OWNER COPY (INITIAL): PINK