IREDELL COUNTY HEALTH DEPARTMENT

STATESVILLE 704-878-5305 CI MOORESVILLE 704-664-5281

IMPROVEMENT PERMIT / AUTHORIZATION TO CONSTRUCT / OPERATION PERMIT / EXISTING SYSTEM INSPECTION

(CI)

PERMIT# 128528 PIN# 3793-55-6596 DATE 9-15-05

OWNER OR CONTRACTOR JOHN CRAVER PHONE: Business 704-663-2220 Home 704-534-4700

ADDRESS 130 LAZY LANE, MOORESVILLE NC 28117

LOCATION OLD MOUNTAIN ROAD TO BEULAH ROAD, CONTINUE MOCK MILL RD, TL TITLEIST DRIVE, 1ST ON LEFT

SUBDIVISION AUGUSTA GREENS BLOCK / SECTION II LOT 39 LOT AREA 0.942 ACRE SITE CLASS PS' DESIGN FLOW 480 L.T.A.R. 0.30 GPD/FT²

Septic Tank: 1000 Gallons; STB 1012 Date 3-18-05

Pump Tank: _____ Gallons; PT _____ Date _____

Pump Make: _____ Model _____ Serial No. _____

Nitrification Field: No Fields 1 Square Feet EQ. TO 1600 Linear Feet 400

No Lines FIVE Trench Width 36" Max Trench Bottom Depth 36" Gravel Depth N/A

☑ New System ☐ Repair System Type: I (II) III IV V VI

System Description: 25% REDUCTION, GRAVITY

Repair System Description: 50% REDUCTION, LOW PRESSURE

Maintenance Agreement Required: ☐ Yes ☑ No

☑ House/Mod. Home No. Bedrooms 4

☐ Mobile Home No. Bathrooms ____

☐ Business No. Employees ____

☐ Other ____

☐ Slab ☑ Crawl Space ☐ Basement w/plumbing ☐ Basement wo/plumbing

Water Supply: ☐ Individual ☑ Public ☐ Community

Comments/Conditions: INSTALL 25% REDUCTION SYSTEM ON CONTOUR AS FLAGGED ON SITE

DO NOT EXCAVATE BELOW GRADE AT REAR OF HOUSE.

Comments/Conditions: [redacted] 10' OFF MARKED P/L CONTOUR


INITIAL SITE SKETCH

SEE ATTACHED "FAST TRACK" SITE SKETCH BY MIKE ATHANAS

AS BUILT SKETCH

SYSTEM INSTALLED BY HOUSE WAS BUILT

SYSTEM SLOPED UP HILL TO FIRST SET 30' LATERALS. BUILDER WAS CALLED & OK'D CHANGES

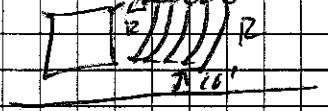


Permit can be suspended or revoked if any false information is supplied toward securing the permit/any unauthorized changes are made to the site/any unauthorized changes are made in the installation of the system. Improvement Permit with plat valid without expiration. Improvement Permit with site plan valid for sixty months. Authorization to Construct is valid for a period equal to that of Improvement Permit – not to exceed sixty months.

Signed: _____ date 9-22-05 Installed by: A-1 BACKHOE

Improvement Permit by: STEVE HENDRICK date 9-15-05 Operation Permit by: _____ date 10-19-05

Authorization to Construct by: STEVE HENDRICK date 10-14-05 Existing System Inspection by: _____ date _____

HEALTH DEPT. COPY: WHITE OWNER COPY (FINAL): YELLOW OWNER COPY (INITIAL): PINK

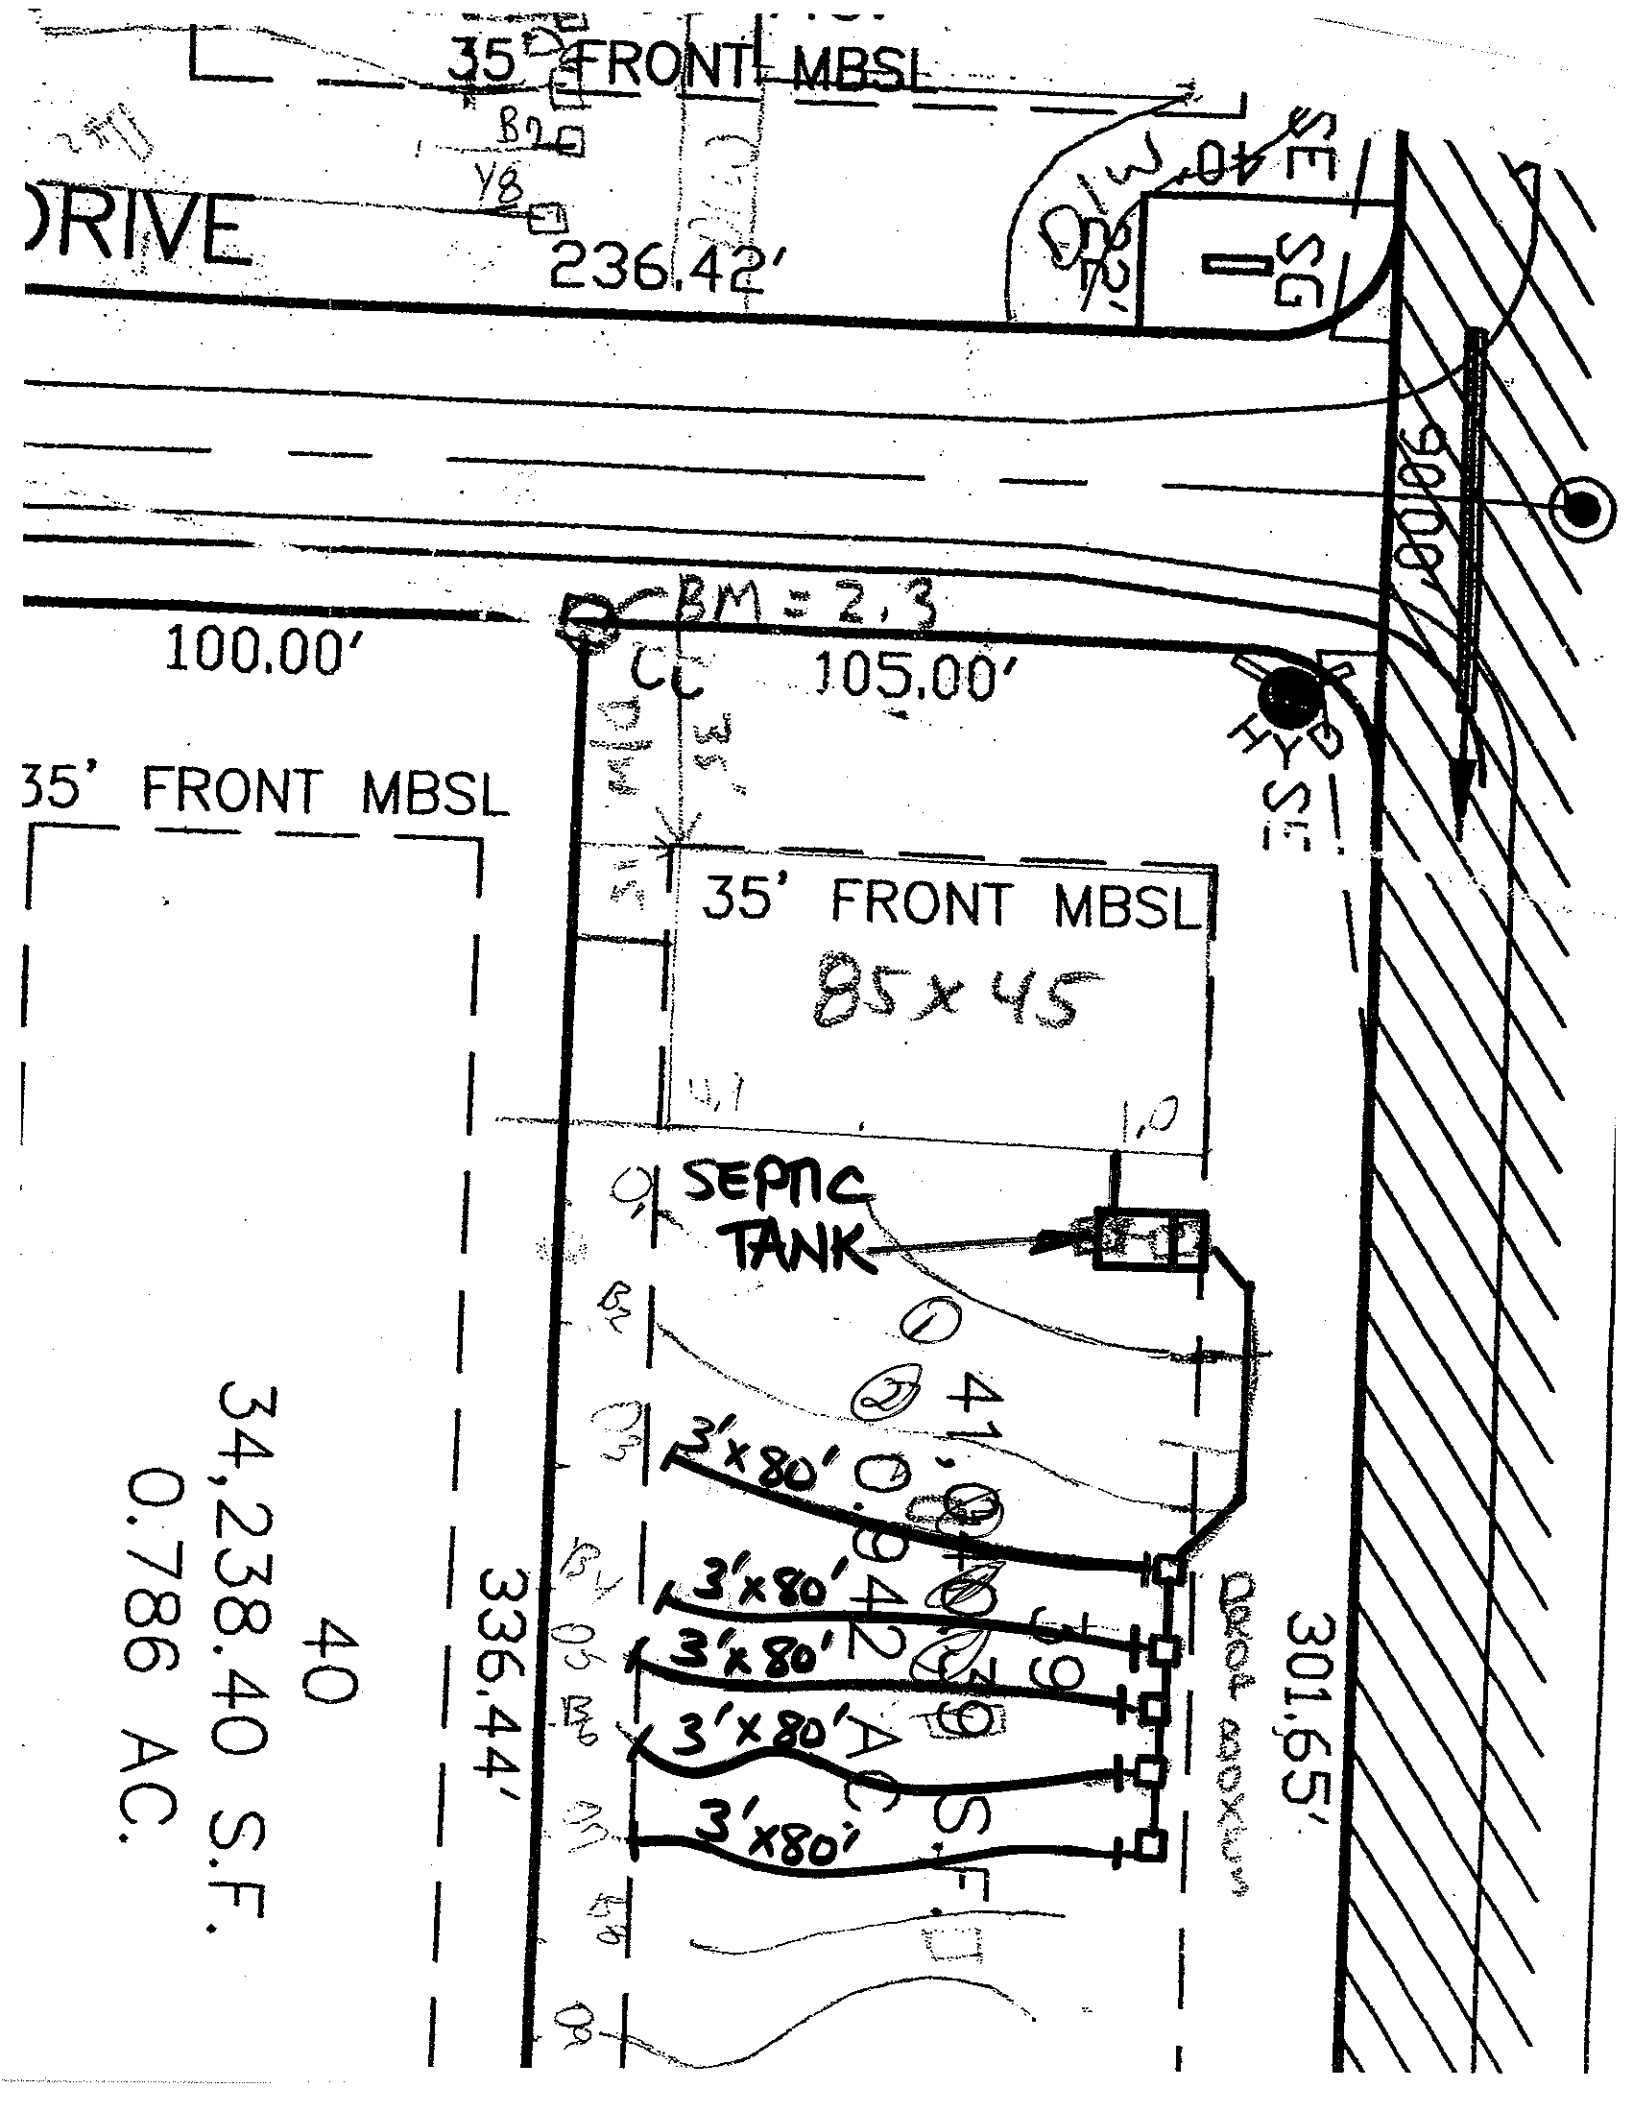
35' FRONT MBSL
DRIVE
236.42'
100.00'
105.00'
BM = 2,3
CC
HYD
35' FRONT MBSL
35' FRONT MBSL
85 x 45
SEPTIC TANK
3'x80'
3'x80'
3'x80'
3'x80'
336.44'
301.65'
40
34,238.40 S.F.
0.786 AC.