IREDELL COUNTY HEALTH DEPARTMENT - *ENVIRONMENTAL HEALTH* ☒ STATESVILLE OFFICE 704-878-5305 ☐ MOORESVILLE OFFICE 704-664-5281

IMPROVEMENT PERMIT / AUTHORIZATION TO CONSTRUCT / OPERATION PERMIT / EXISTING SYSTEM INSPECTION

PERMIT # 1166476 PIN # 3793-55-8086 DATE 5-27-11

OWNER Kim Rivera APPLICANT: Capote Builders PHONE: Home/Cell # 704-400-5481 Business #

SITE ADDRESS 127 Titleist OWNER / APPLICANT ADDRESS

SITE DIRECTIONS I-40 W, Sharon School Rd., Mock Mill Rd. (R) on Titleist site on (L) across from Top Flight Rd.

SUBDIVISION Augusta Greens II BLOCK / SECTION LOT # 43 LOT AREA 4.664 DESIGN FLOW 360 L.T.A.R. .3

Septic Tank 1000 Gallons: STB 760 Date 4/12

Pump Tank Gallons: P T Date

Pump Make Model Serial #

No. Nitrification Fields: 1 No. Lines 3 Linear Feet 300

Trench Width 36" Max. Trench Bottom Depth 36" Gravel Depth 9/12

☒ New System ☐ Repair ☐ Expansion System Type I II (III) IV V VI

System Description: 25% Reduction

Repair System Description: 25% Reduction

Maintenance Agreement Required ☐ YES ☒ NO

☒ GRAVITY ☐ PRESSURE

☒ Residence No. Bedrooms 3

☐ Business No. Persons

☐ Other No. Employees

☐ Slab ☐ Crawl Space


☒ Basement w/plumbing ☐ Basement w/o plumbing

Water Supply: ☐ Private ☒ Public ☐ Community


Comments / Conditions

1" = 60'

INITIAL SITE SKETCH

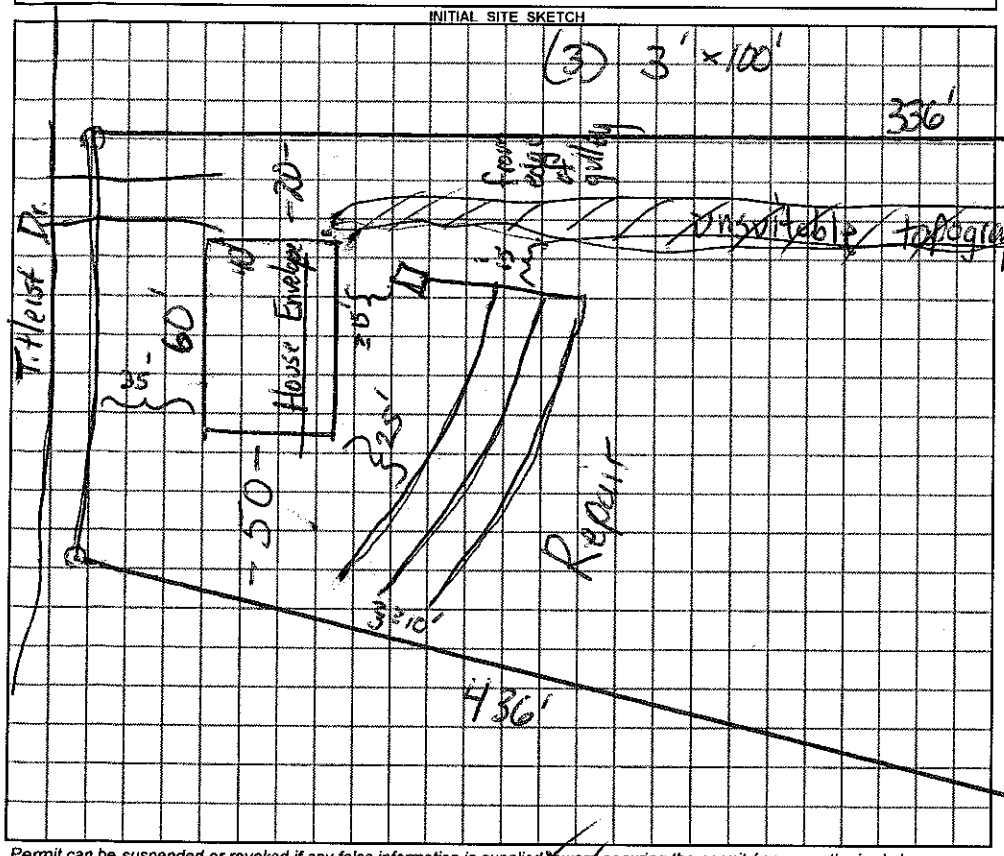

AS BUILT SKETCH

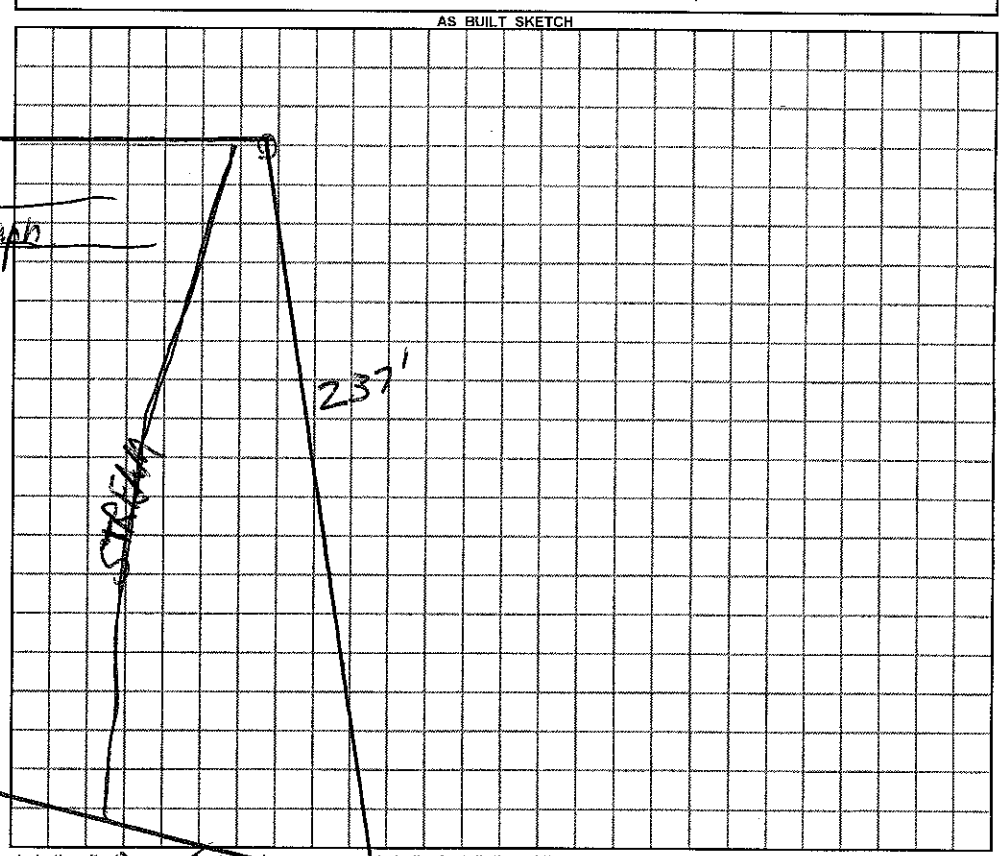

Permit can be suspended or revoked if any false information is supplied toward securing the permit / any unauthorized changes are made to the site / any unauthorized changes are made in the installation of the system.

☐ *IMPROVEMENT PERMIT with plat valid without expiration.* ☒ *IMPROVEMENT PERMIT with ~~plat valid without expiration.~~ site plan valid 60 mo.* ☒ *AUTHORIZATION TO CONSTRUCT* valid for period equal to IMPROVEMENT PERMIT--not to exceed 60 mo.

Owner / Applicant Signature: Kim Rivera Date 5/31/11

IMPROVEMENT PERMIT by: REHS Date 5-27-11

AUTHORIZATION TO CONSTRUCT by: REHS Date 5-27-11

YOU SHOULD CONTACT A LOCATOR SERVICE PRIOR TO ANY EXCAVATION

Installed by: Gunter Grading

OPERATION PERMIT by: REHS Date 15 Aug. 11

Existing System Inspected by: REHS Date

White Copy – Environmental Health YELLOW COPY (Final) Owner / Applicant PINK COPY (Initial) Owner / Applicant