This Permit Voids Previous Issued Permit issued 7-11-00 and Permit # 82173.

IREDELL COUNTY HEALTH DEPARTMENT

STATESVILLE 704-878-5305 MOORESVILLE 704-664-5281

IMPROVEMENT PERMIT / AUTHORIZATION TO CONSTRUCT / OPERATION PERMIT / EXISTING SYSTEM INSPECTION

PERMIT# 90400 PIN# 3795562140 DATE 4/9/01

OWNER OR CONTRACTOR Unity Independent Baptist Church PHONE: Business (704) 528-0791 Home

ADDRESS 660 Mock Mill Rd Statesville, NC 28677

LOCATION I-40 W to Old NC Rd. (R) Beulah Rd (R) Mock Mill 1/2 mile on Right

SUBDIVISION BLOCK / SECTION LOT LOT AREA 5.24 Acres SITE CLASS PS DESIGN FLOW 600 L.T.A.R. -35

Septic Tank: 4,500 Gallons; STB 268 Date 11-25-00
Pump Tank: Gallons; PT Date
Pump Make: Model equivalent to Serial No
Nitrification Field: No Fields 1 Square Feet 1214 Linear Feet 428 ft
No Lines Trench Width 36" Max Trench Bottom Depth 30" Gravel Depth N/A


[X] New System [ ] Repair System Type: I, II, III, IV, V, VI
System Description: Gravity, 25% Reduction
Repair System Description: Gravity, 25% Reduction
Maintenance Agreement Required: [ ] Yes [X] No
[ ] Slab [ ] Crawl Space [ ] Basement w/plumbing [ ] Basement wo/plumbing

[ ] House/Mod. Home No. Bedrooms
[ ] Mobile Home No. Bathrooms
[ ] Business No. Employees
[X] Other Church - 120 seat sanctuary

Water Supply: [X] Individual [ ] Public [ ] Community


Comments/Conditions: (1) Install lines on contour (2) Keep Lines 10ft From property Line (3) use Chamber or HDPE Sections

INITIAL SITE SKETCH

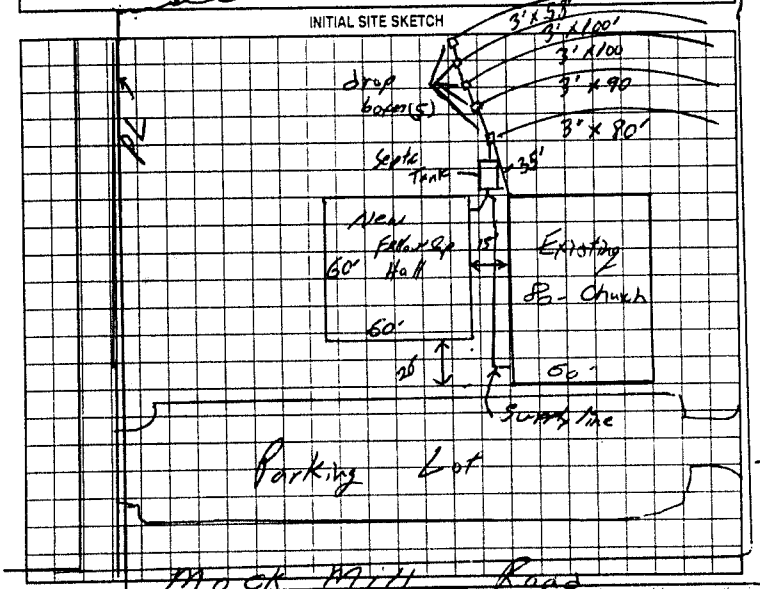

Comments/Conditions: - Infi/Hrstr Chamber Installed - Septic Tank Marker Installed & Septic Tank Riser w/ Lock Hole - Poly Sok Filter Installed

AS BUILT SKETCH

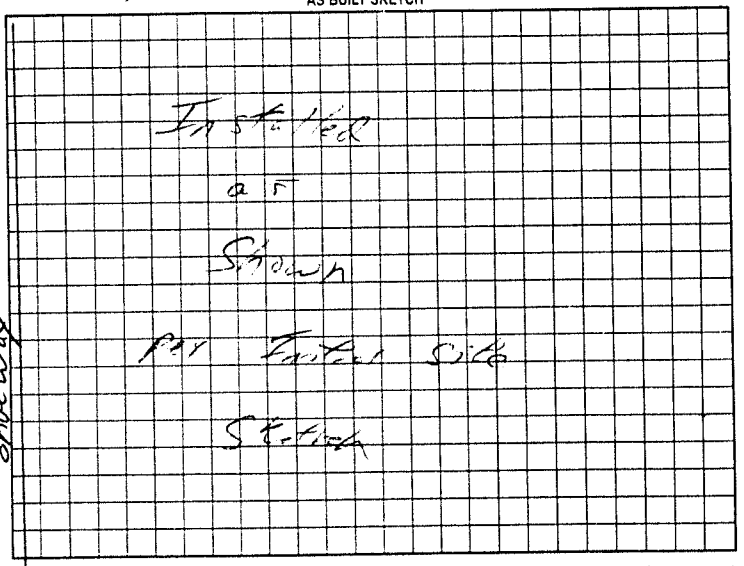

Permit can be suspended or revoked if any false information is supplied toward securing the permit/any unauthorized changes are made to the site/any unauthorized changes are made in the installation of the system. Improvement Permit with plat valid without expiration. Improvement Permit with site plan valid for sixty months. Authorization to Construct is valid for a period equal to that of Improvement Permit – not to exceed sixty months.

Signed: Anna L Cape date 4/9/01

Improvement Permit by: William O. Johnson RSI date 4/9/01

Authorization to Construct by: William O. Johnson RSI date 4/9/01

Installed by: Jody Travis

Operation Permit by: William O. Johnson date 6/14/01

Existing System Inspection by: date

HEALTH DEPT COPY WHITE OWNER COPY (FINAL) YELLOW OWNER COPY (INITIAL) PINK