IREDELL COUNTY HEALTH DEPARTMENT

STATESVILLE 704-878-5305 MOORESVILLE 704-664-5281

IMPROVEMENT PERMIT / AUTHORIZATION TO CONSTRUCT / OPERATION PERMIT / EXISTING SYSTEM INSPECTION

PERMIT # 16/469 PIN # 3793-61-9247 DATE 23 June 10

OWNER or APPLICANT Joseph Lovaglio PHONE: Business cell (704) 402-3789 Home: (704) 498-0047

OWNER or APPLICANT ADDRESS 121 Volt Circle Statesville

LOCATION / DIRECTIONS Old NW Rd. Turn onto Hwy 70W TR Deer Trail Rd. - on Rt.

SUBDIVISION BLOCK / SECTION LOT # LOT AREA 5.26ac. DESIGN FLOW 360g/d L.T.A.R. 0.3 gal/ft²/d

Septic Tank Exist. Gallons: STB Date

Pump Tank Gallons: P T Date

Pump Make Model Serial #

Nitrification Field No Fields 1 No Lines 1 Linear Feet 100'

Trench Width 36" Max. Trench Bottom Depth 36" Gravel Depth N/A

☐ New System ☐ Repair ☑ Expansion System Type I II (III) IV V VI

System Description: 25% Reduction

Repair System Description: 25% Reduction

Maintenance Agreement Required ☐ YES ☐ NO

☑ GRAVITY ☐ PRESSURE

☑ Residence No. Bedrooms Add 1

☐ Business No. Persons

☐ Other No. Employees

☐ Slab ☑ Crawl Space


☐ Basement w/plumbing ☐ Basement w/o plumbing

Water Supply: ☑ Private ☐ Public ☐ Community

Comments / Conditions: Add 100' of 25% Reduction System. Keep well 100' from system.

Comments / Conditions

INITIAL SITE SKETCH

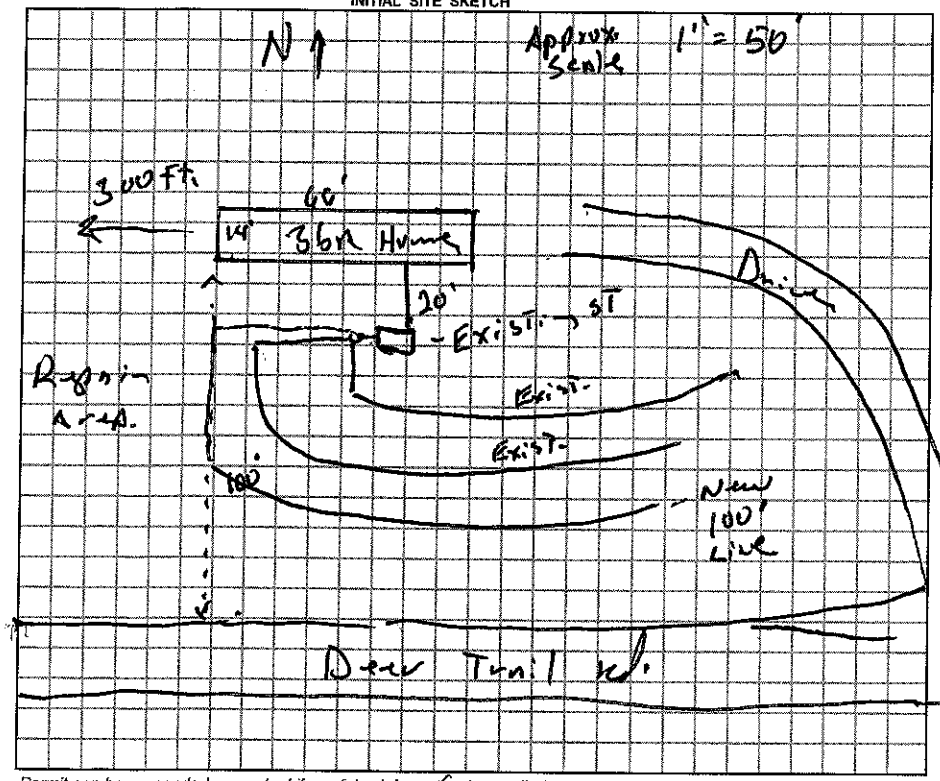

AS BUILT SKETCH

Permit can be suspended or revoked if any false information is supplied toward securing the permit / any unauthorized changes are made to the site / any unauthorized changes are made in the installation of the system.

☐ *IMPROVEMENT PERMIT w / plat valid without expiration.* ☑ *IMPROVEMENT PERMIT w / site plan valid for 60 mos.* ☑ *AUTHORIZATION TO CONSTRUCT valid for period equal to IMPROVEMENT PERMIT-not to exceed 60 mo.*

Owner / Applicant Signature: Joseph LoVaglio Date 6/24/10

Improvement Permit by: [signature], R.S. Date 23 June 10

Authorization to Construct by: [signature], R.S. Date 23 June 10

Installed by: A-1

Operation Permit by: [signature], R.S. Date: 29 June 10

Existing System Inspected by: Date:

YOU SHOULD CONTACT A LOCATOR SERVICE PRIOR TO ANY EXCAVATION.

WHITE COPY Environmental Health YELLOW COPY (Final) Owner / Applicant PINK COPY (Initial) Owner / Applicant