# IREDELL COUNTY HEALTH DEPARTMENT

STATESVILLE 704-878-5305 MOORESVILLE 704-664-5281

## IMPROVEMENT PERMIT / AUTHORIZATION TO CONSTRUCT / OPERATION PERMIT / EXISTING SYSTEM INSPECTION

CI

(11)

PERMIT# 141669 PIN# 3793632980 DATE 4-18-07

OWNER OR APPLICANT AMERICA'S HOME PLACE, INC PHONE: Business 704-746-7094 Home 704-664-5800

ADDRESS 168-D NORMAN SHARON BLVD, MOORESVILLE, NC 28117

LOCATION I-40 W, TL SHARON SCH. RD, TL MOCK MILL ROAD, TR TITLEIST DR, 1ST LOT ON LEFT PAST SPALDING CT.

SUBDIVISION AUGUSTA GREENS BLOCK / SECTION 2 LOT 54 LOT AREA 1.292 ACRES SITE CLASS. PS DESIGN FLOW 360 L.T.A.R. 0.25 GPD/FT²

Septic Tank: 1000 Gallons: ST8 1007 Date 5-14-07

Pump Tank: _____ Gallons: PT _____ Date _____

Pump Make: _____ Model _____ Serial No. _____

Nitrification Field: No Fields 1 Square Feet 1440 Linear Feet 360

No Lines FIVE Trench Width 36" Max Trench Bottom Depth 30" Gravel Depth N/A

☒ New System ☐ Repair ☐ Expansion System Type: I II III IV V VI

System Description: 25% REDUCTION, GRAVITY

Repair System Description: 25% REDUCTION, PUMP

Maintenance Agreement Required: ☐ Yes ☒ No

☒ House/Mod. Home ☐ Mobile Home ☐ Business ☐ Other

No. Bedrooms 3 No. Persons ____ No. Employees ____


Water Supply: ☐ Individual ☒ Public ☐ Community

☐ Gravity ☐ Pressure ☐ Slab ☐ Crawl Space ☐ Basement w/plumbing ☐ Basement wo/plumbing


Comments/Conditions: ① INSTALL 25% REDUCTION SYSTEM ON CONTOUR, NO DEEPER THAN 30 INCHES. ② CONTACT HEALTH DEPT. AFTER CLEARING & PRIOR TO INSPECTION TO FLAG OUT SYSTEM

Comments:/Conditions:

INITIAL SITE SKETCH

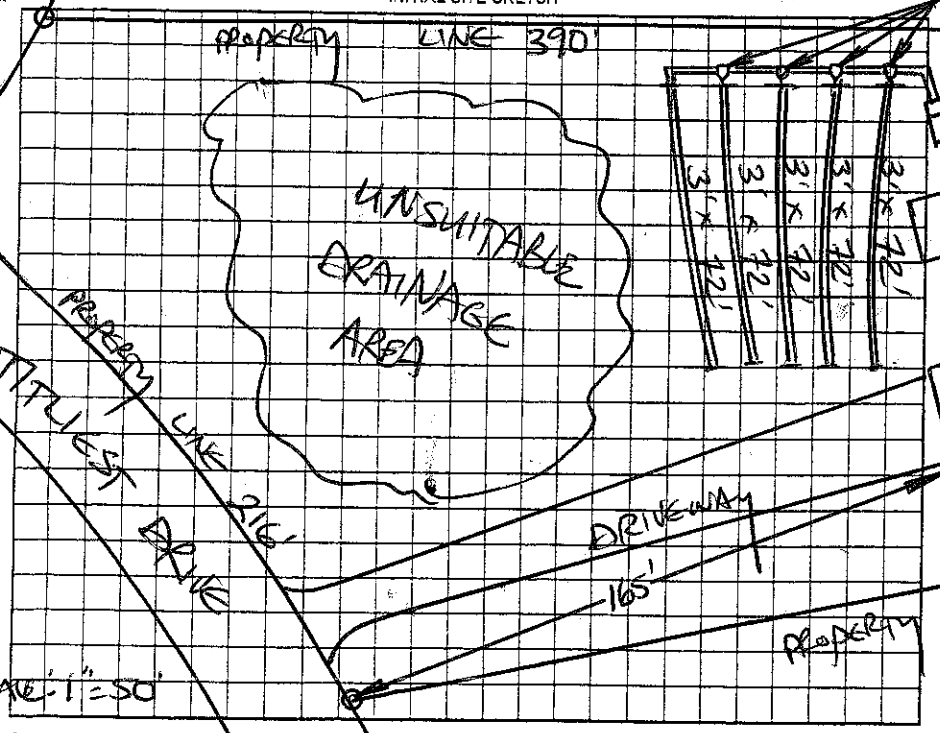


AS BUILT SKETCH

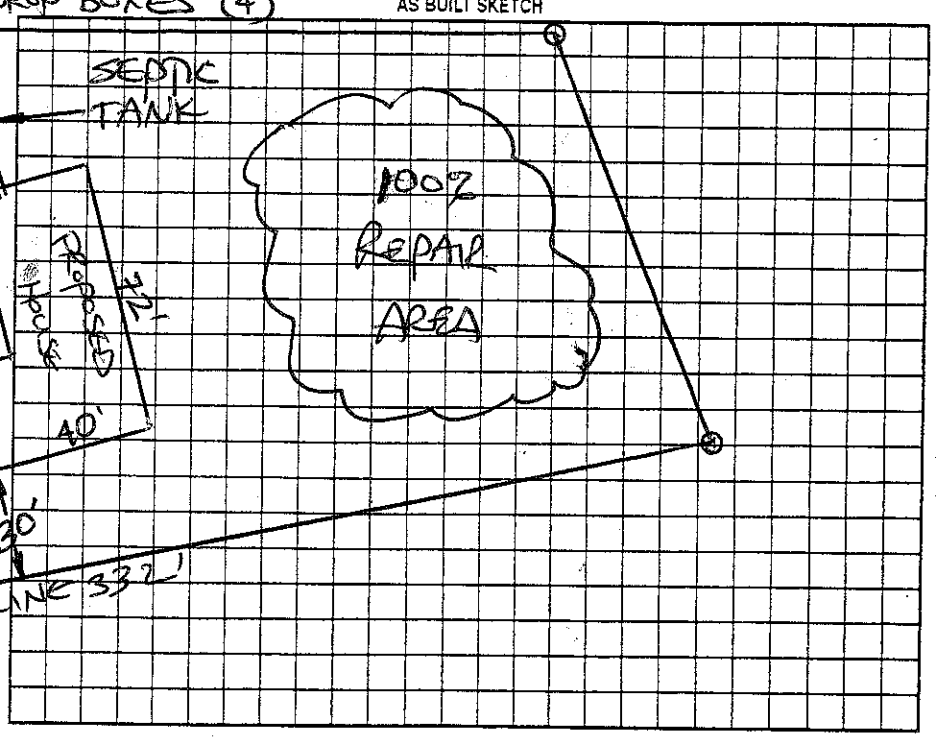


Permit can be suspended or revoked if any false information is supplied toward securing the permit/any unauthorized changes are made to the site/any unauthorized changes are made in the installation of the system. Improvement Permit with plat valid without expiration ☐ Improvement Permit with site plan valid for sixty months ☒ Authorization to Construct is valid for a period equal to that of Improvement Permit – not to exceed sixty months.

Signed: Charles Hellen date 4-18-07

Improvement Permit by: STEVE HENDRICK date 4-18-07

Authorization to Construct by: STEVE HENDRICK date 4-18-07

Installed by: K&M Grading

Operation Permit by: James date 7-2-07

Existing System Inspection by: _____ date _____

HEALTH DEPT. COPY: WHITE OWNER COPY (FINAL): YELLOW OWNER COPY (INITIAL): PINK