IREDELL COUNTY HEALTH DEPARTMENT

STATESVILLE 704-878-5305 MOORESVILLE 704-664-5281

IMPROVEMENT PERMIT / AUTHORIZATION TO CONSTRUCT / OPERATION PERMIT / EXISTING SYSTEM INSPECTION

PERMIT# 139163 PIN# 3793-63-3377 3793-63-4434 DATE 4.18.07

OWNER OR APPLICANT TERRY MICHAEL PHONE: Business Home 704-402-8848

ADDRESS P.O. Box 1228 Mooresville, NC 28115

LOCATION TOWN TL SHARON SCHOOL RD TL MOCK MILL RD TR TITLEST DRIVE, LOT AT END ON

SUBDIVISION AUGUSTA GREENS BLOCK / SECTION II LOT 57/58 LOT AREA 3.071 ACRE SITE CLASS PS DESIGN FLOW 360 L.T.A.R. 0.30 gpd/ft²

Septic Tank: 1000 Gallons; STB 760 Date 11-12-01

Pump Tank: 1000 Gallons; PT 3763 Date 4/07

Pump Make: Zoeller Model PW1521B Serial No. 15P4480

Nitrification Field: No Fields 1 Square Feet 1200 Linear Feet 300

No Lines Four Trench Width 36" Max Trench Bottom Depth 30"

☑ New System ☐ Repair ☐ Expansion System Type: I II (III) IV V VI

System Description: 25% REDUCTION PUMP

Repair System Description: 25% REDUCTION PUMP

Maintenance Agreement Required: ☐ Yes ☑ No

Gravel Depth N/A ☐ Gravity ☑ Pressure

☑ House/Mod. Home ☐ Mobile Home ☐ Business ☐ Other

No. Bedrooms 3 No. Persons ___ No. Employees ___


Water Supply: ☐ Individual ☑ Public ☐ Community

☐ Slab ☐ Crawl Space ☑ Basement w/plumbing ☐ Basement wo/plumbing


Comments:/Conditions: ① INSTALL 25% REDUCTION SYSTEM ON CONTOUR NO DEEPER THAN 30 INCHES. ② SEE ATTACHED SHEETS for PUMP & PRESSURE MANIFOLD REQUIREMENTS

Comments:/Conditions: Red Jug right Septic Marker

INITIAL SITE SKETCH

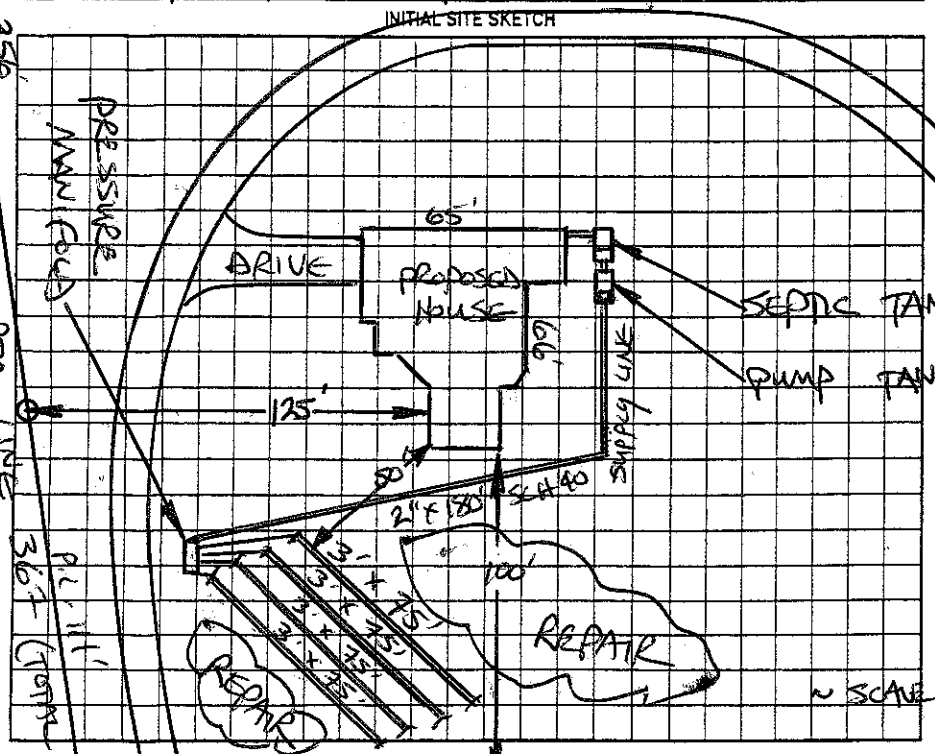

AS BUILT SKETCH

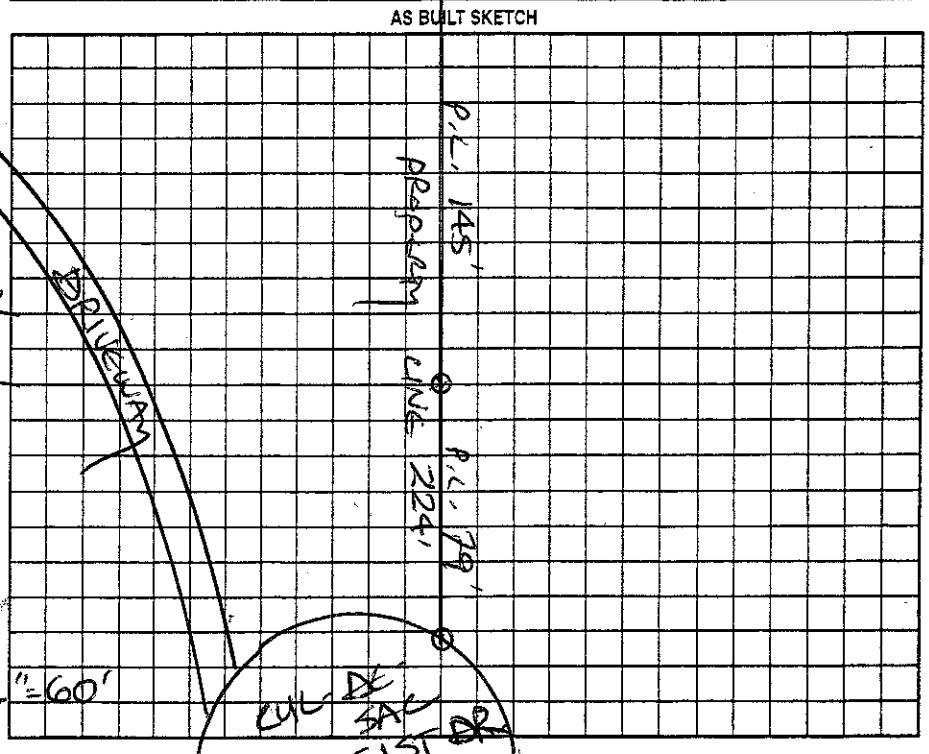

Permit can be suspended or revoked if any false information is supplied toward securing the permit/any unauthorized changes are made to the site/any unauthorized changes are made in the installation of the system. Improvement Permit with plat valid without expiration. ☐ Improvement Permit with site plan valid for sixty months ☑ Authorization to Construct is valid for a period equal to that of Improvement Permit – not to exceed sixty months.

Signed: Terry Michael date 4/19/07 Installed by: Tim Abee

Improvement Permit by: STEVE HEDRICK date 4-18-07 Operation Permit by: R.S. date 19 Nov. 08

Authorization to Construct by: STEVE HEDRICK date 4-18-07 Existing System Inspection by: ___ date ___

HEALTH DEPT. COPY: WHITE OWNER COPY (FINAL): YELLOW OWNER COPY (INITIAL): PINK