IREDELL COUNTY HEALTH DEPARTMENT

STATESVILLE 704-878-5305 MOORESVILLE 704-664-5281

IMPROVEMENT PERMIT / AUTHORIZATION TO CONSTRUCT / OPERATION PERMIT / EXISTING SYSTEM INSPECTION

PERMIT# Repair PIN# 3793-65-9270 DATE 6/16/03

OWNER OR CONTRACTOR Bernard R. Clewer PHONE: Business Home 873-9828

ADDRESS 132 Mott Park Drive Statesville NC 28677

LOCATION I-40 E, Sharon School Rd, L mock mill Rd, R Mott Park Drive, 3rd House on Lt @ 126 Mott

SUBDIVISION BLOCK / SECTION LOT LOT AREA SITE CLASS. Ep DESIGN FLOW 360 L.T.A.R. Ep

Septic Tank: ~~1000~~ 1,000 Gallons; STB Date

Pump Tank: Gallons; PT Date

Pump Make: Model Serial No.

Nitrification Field: No Fields 1 Square Feet Linear Feet 90

No Lines 2 @ 45 Trench Width 36" Max Trench Bottom Depth — Gravel Depth 24"

☐ New System ☒ Repair System Type: I, ☐ II, III, IV, V, VI

System Description:

Repair System Description: Gravity Conv.

Maintenance Agreement Required: ☐ Yes ☒ No

☐ House/Mod. Home ☒ Mobile Home ☐ Business ☐ Other

No. Bedrooms No. Bathrooms No. Employees


☐ Slab ☒ Crawl Space ☐ Basement w/plumbing ☐ Basement wo/plumbing

Water Supply: ☐ Individual ☐ Public ☐ Community


Comments:/Conditions: ① Add two lines @ 45' with 16.3' of 24" gravel ② Ok. 3rd line 30 ft. ③ Pump ST before installation

Comments:/Conditions: - replaced Septic Tee - System Fills 30, 45, 45 Ft lines 1st, then goes to old Existing Lines.

INITIAL SITE SKETCH

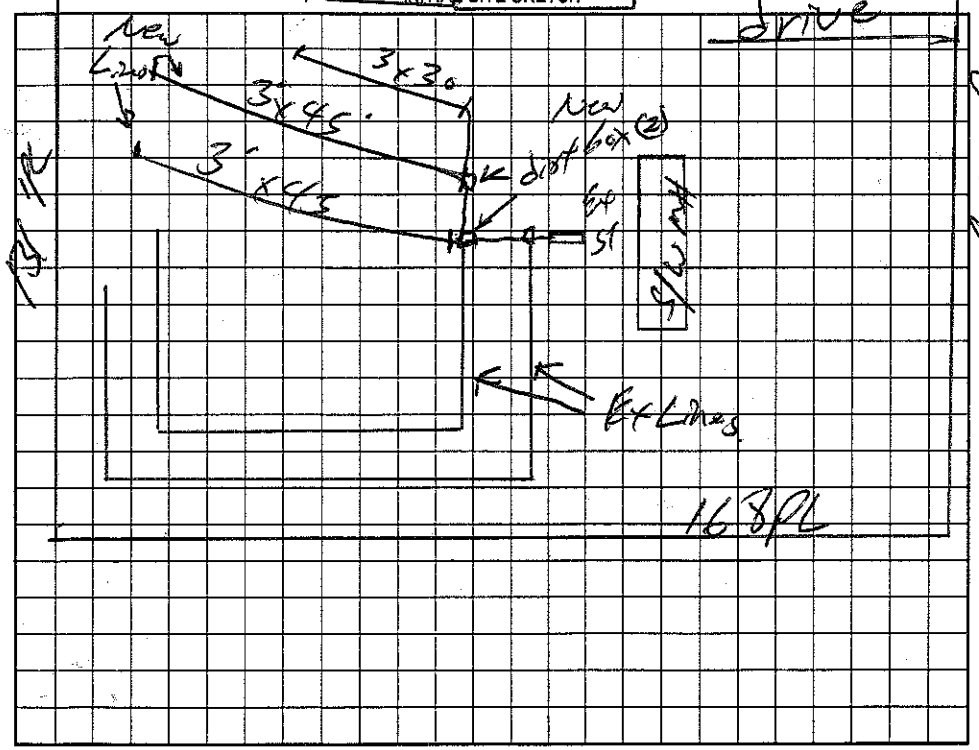

AS BUILT SKETCH (Not To Scale)

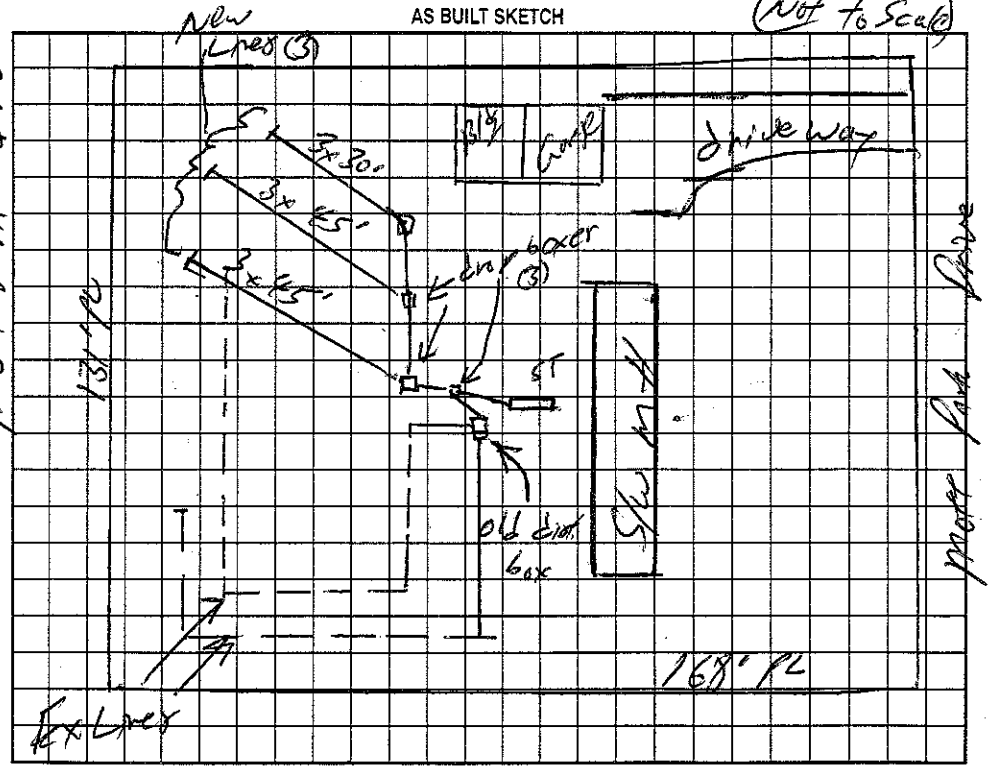

Permit can be suspended or revoked if any false information is supplied toward securing the permit/any unauthorized changes are made to the site/any unauthorized changes are made in the installation of the system. Improvement Permit with plat valid without expiration. Improvement Permit with site plan valid for sixty months. Authorization to Construct is valid for a period equal to that of Improvement Permit – not to exceed sixty months.

Signed: Bernard R Clewer date 6-16-03 Installed by: James Hucker

Improvement Permit by: William O. Johnson date 6/16/03 Operation Permit by: William O. Johnson date 9-12-03

Authorization to Construct by: William O. Johnson date 6/16/03 Existing System Inspection by: date

HEALTH DEPT. COPY: WHITE OWNER COPY (FINAL): YELLOW OWNER COPY (INITIAL): PINK