47292

IREDELL COUNTY HEALTH DEPARTMENT

STATESVILLE 704-878-5305 MOORESVILLE 704-664-5281

IMPROVEMENT PERMIT / CERTIFICATE OF COMPLETION / OPERATION PERMIT / EXISTING SYSTEM INSPECTION

PROPERTY DESCRIPTION NO. 16144 DATE 6-17-93 TAX MAP NO. 8H-5-B-12/13

OWNER OR CONTRACTOR Stan Clardy PHONE: Business _____ Home 871-8287

ADDRESS _____

LOCATION I40 W TL Old Mtn. Rd. TR Beulah Rd, Stay straight Mock Mill Rd. TR Hoke Circle 2nd & 3rd Lot on R.

SUBDIVISION HokeLand BLOCK / SECTION _____ LOT 12/13 LOT AREA .99 acre SITE CLASS. P.S. L.T.A.R. .35 gpd/ft²

Water Supply: ☑ Individual ☐ Community ☐ Public Well

Septic Tank: 1000 Gallons; STB 901 Date 4-7-93

Pump Tank: — Gallons; PT — Date —

Nitrification Field: No Fields 1 Square Feet 1035 Linear Feet 345'

No Lines 4 Trench Width 36" Trench Depth 36" Gravel Depth 12"

☑ New System ☐ Repair System Type: I. (II.) III. IV. V. VI

System Description: Conventional, gravity

Repair System Description: Pump to conventional

Maintenance Agreement Required: ☐ Yes ☐ No

☐ House/Mod. Home ☑ Mobile Home ☐ Business ☐ Other

No. Bedrooms 3 No. Bathrooms 2.5 No. Employees —

Garbage Disposal: ☐ Yes ☑ No

Auto. Dishwasher: ☑ Yes ☐ No


Auto. Washing Machine: ☑ Yes ☐ No

Other _____


☐ Slab ☑ Crawl Space ☐ Basement w/plumbing ☐ Basement wo/plumbing

Comments 100% Repair Area above system, pump to conventional.

INITIAL SITE SKETCH

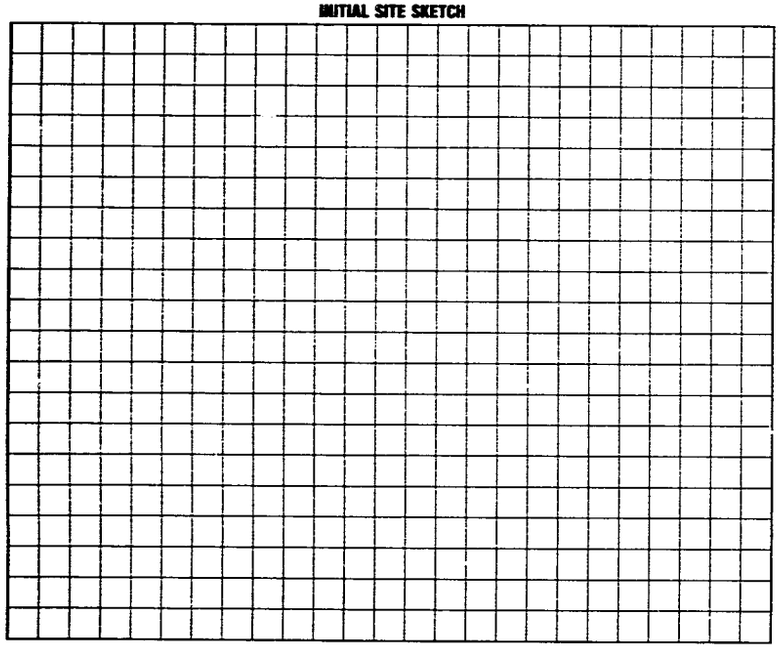

AS BUILT SKETCH

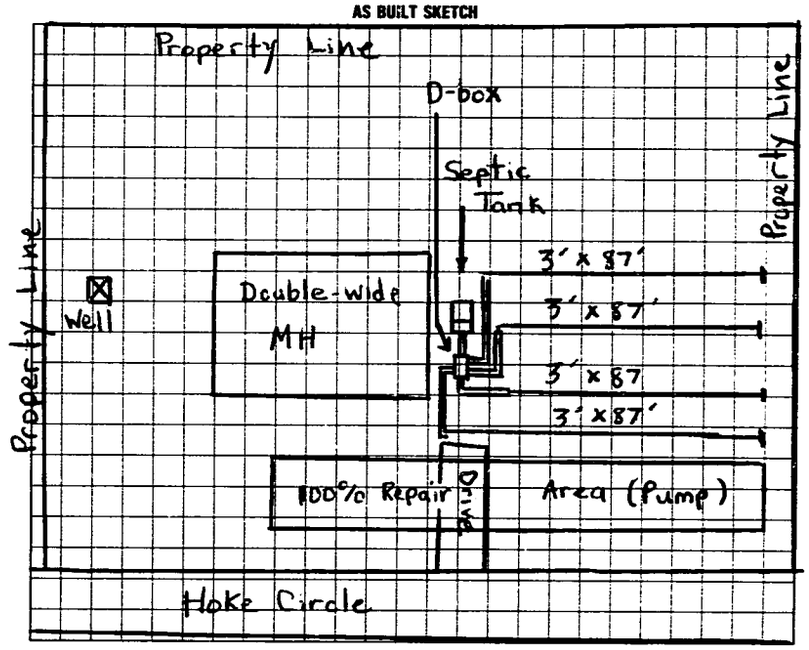

I understand that this permit can be suspended or revoked if any false information is supplied toward securing the permit/any unauthorized changes are made to the site/any unauthorized changes are made in the installation of the system. Improvement Permit is valid for 60 months from date of issuance.

Signed: _____

Improvement Permit by: Michael J. Dennis date 5-19-93

Existing System Inspection by: _____ date _____

Installed by: Cline & Gillan

Certificate of Completion by: Michael J. Dennis date 6-17-93

Operation Permit by: _____ date _____

HEALTH DEPT. COPY: WHITE INSPECTION COPY (FINAL): GREEN OWNER COPY (FINAL): YELLOW INSPECTION COPY (INITIAL): PINK OWNER COPY (INITIAL): GOLD