IREDELL COUNTY HEALTH DEPARTMENT

STATESVILLE 704-878-5305 MOORESVILLE 704-664-5281 (C1)

IMPROVEMENT PERMIT / AUTHORIZATION TO CONSTRUCT / OPERATION PERMIT / EXISTING SYSTEM INSPECTION

PERMIT# 124603 PIN# 3793-69-7369 DATE 11-17-04

OWNER OR CONTRACTOR WAYNE HOMES MID ATLANTIC, LLC PHONE: Business 704-872-8989 Home

ADDRESS 170 BELLE HERITAGE TRAIL, STATESVILLE NC 28625

LOCATION ISLAND FORD ROAD TO GOBLE ROAD, GO 0.3 MILE TL BELLE HERITAGE TRAIL, AT END ON RIGHT

SUBDIVISION BLOCK / SECTION LOT LOT AREA 25.43 ACRES SITE CLASS. PS DESIGN FLOW 360 L.T.A.R. EXISTING 0.4

Septic Tank: 1000 Gallons; STB Date

Pump Tank: Gallons; PT Date

Pump Make: Model Serial No.

Nitrification Field: No Fields 1 Square Feet 900 Linear Feet 300

No Lines TWO Trench Width 36" Max Trench Bottom Depth Gravel Depth 12"

☐ New System ☐ Repair System Type: (I) II, III, IV, V, VI

System Description: CONVENTIONAL, REPAIR

Repair System Description:

Maintenance Agreement Required: ☐ Yes ☑ No

☑ House/Mod. Home No. Bedrooms 3

☐ Mobile Home No. Bathrooms

☐ Business No. Employees

☐ Other

☐ Slab ☑ Crawl Space ☐ Basement w/plumbing ☐ Basement wo/plumbing

Water Supply: ☑ Individual ☐ Public ☐ Community


WELL

Comments:/Conditions:

Comments:/Conditions:

INITIAL SITE SKETCH

AS BUILT SKETCH

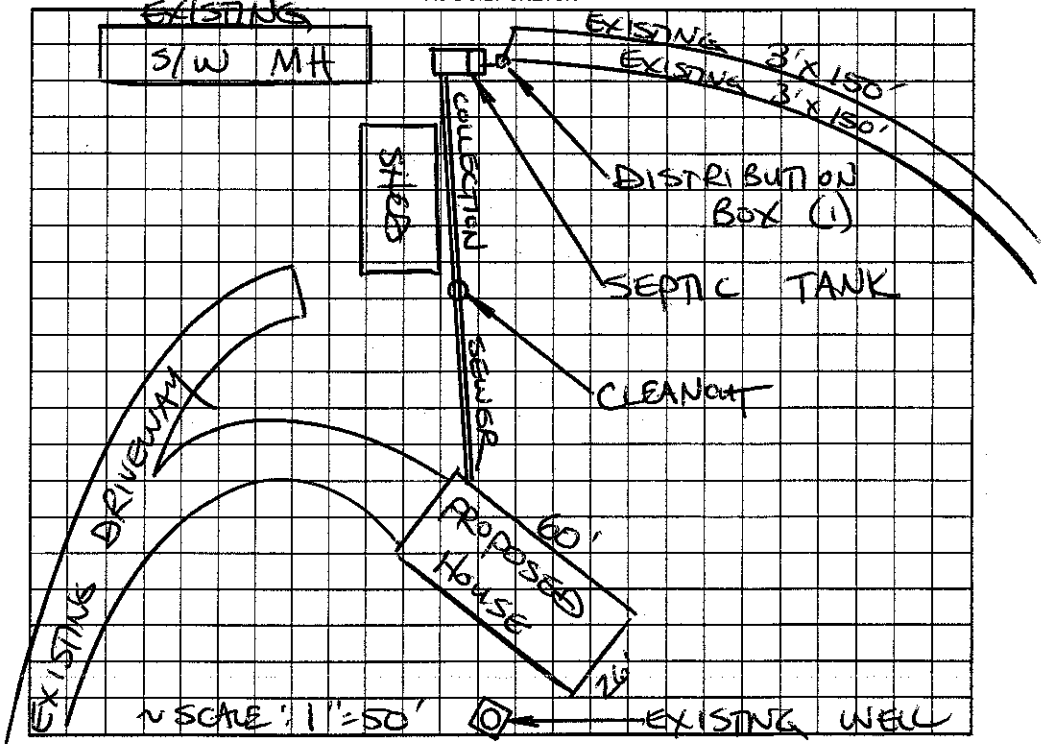

Permit can be suspended or revoked if any false information is supplied toward securing the permit/any unauthorized changes are made to the site/any unauthorized changes are made in the installation of the system. Improvement Permit with plat valid without expiration. Improvement Permit with site plan valid for sixty months. Authorization to Construct is valid for a period equal to that of Improvement Permit – not to exceed sixty months.

Signed: date

Improvement Permit by: date

Authorization to Construct by: date

Installed by:

Operation Permit by: date

Existing System Inspection by: STEVE HEDRICK date 11-17-04

HEALTH DEPT. COPY: WHITE OWNER COPY (FINAL): YELLOW OWNER COPY (INITIAL): PINK