IREDELL COUNTY HEALTH DEPARTMENT

STATESVILLE 704-878-5305 MOORESVILLE 704-664-5281

IMPROVEMENT PERMIT / CERTIFICATE OF COMPLETION / OPERATION PERMIT / EXISTING SYSTEM INSPECTION

PROPERTY DESCRIPTION NO. 067776 DATE 6-20-97 TAX MAP NO. 3793745286 Watershed: ☐ Yes ☐ No

OWNER OR CONTRACTOR Oliver D Keiser PHONE: Business Home 873-0889

ADDRESS 179 Matt Rd Statesville

LOCATION I40W TL Old Mtnrd TL Berulah Church Stg. Mock Mill TL Mt Park Dr. Last house Left

SUBDIVISION BLOCK / SECTION LOT LOT AREA SITE CLASS DESIGN FLOW L.T.A.R.

Septic Tank: 1500 Exist. Gallons; STB Date

Pump Tank: Gallons; PT Date

Pump Make: Model Serial No.

Nitrification Field: No Fields Square Feet 720 Linear Feet 240

No Lines Trench Width Max Trench Bottom Depth Gravel Depth

☐ New System ☐ Repair System Type: I, II, III, IV, V, VI

System Description:

Repair System Description:

Maintenance Agreement Required: ☐ Yes ☐ No

☐ House/Mod. Home ☒ Mobile Home ☐ Business ☐ Other

No. Bedrooms 2 No. Bathrooms 1 No. Employees

☐ Slab ☐ Crawl Space ☐ Basement w/plumbing ☐ Basement wo/plumbing


Water Supply: ☒ Individual ☐ Community ☐ Public

Comments:

Comments:
Existing System Check
Keep 5ft from System.

INITIAL SITE SKETCH

AS BUILT SKETCH

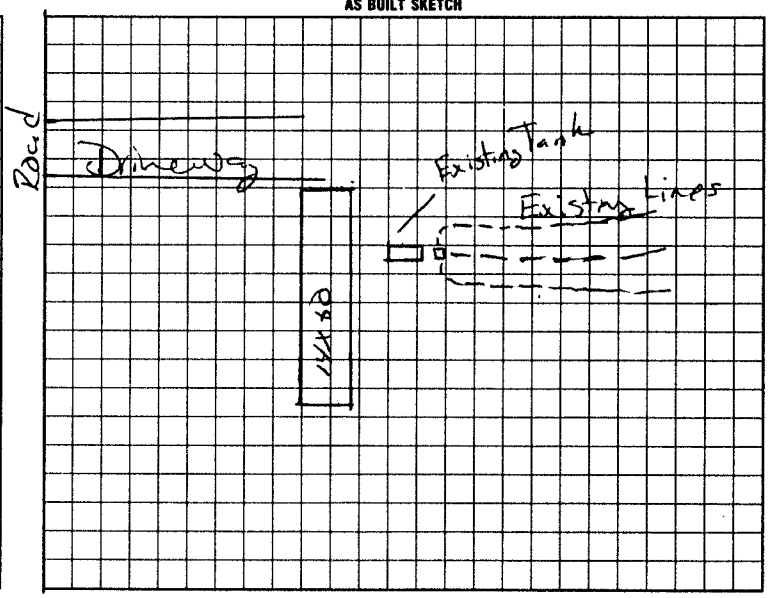

I understand that this permit can be suspended or revoked if any false information is supplied toward securing the permit/any unauthorized changes are made to the site/any unauthorized changes are made in the installation of the system. Improvement Permit is valid for 60 months from date of issuance.

Signed: Betty Jo Keiser

Improvement Permit by: date

Existing System Inspection by: RS date 6-20-97

Installed by:

Certificate of Completion by: date

Operation Permit by: date

HEALTH DEPT. COPY: WHITE INSPECTION COPY (FINAL): GREEN OWNER COPY (FINAL): YELLOW INSPECTION COPY (INITIAL): PINK OWNER COPY (INITIAL): GOLD