2:00

IREDELL COUNTY HEALTH DEPARTMENT

STATESVILLE 704-878-5305 MOORESVILLE 704-664-5281

IMPROVEMENT PERMIT / AUTHORIZATION TO CONSTRUCT / OPERATION PERMIT / EXISTING SYSTEM INSPECTION

PERMIT# 92613 PIN# 3793666694 DATE 10/23/00

OWNER OR CONTRACTOR Robin Johnson PHONE: Business _____ Home 871-1781

ADDRESS 586 MockMill Rd Statesville NC 28677

LOCATION 70W, R Benfield, L Mock mill, on Rt before Mott Park

SUBDIVISION — BLOCK / SECTION — LOT — LOT AREA _____ SITE CLASS PS DESIGN FLOW 360 L.T.A.R. 0.3

Septic Tank: 1000 Gallons: STB 102 Date 8-31-00
Pump Tank: _____ Gallons: PT _____ Date _____
Pump Make: _____ Model _____ Serial No _____
Nitrification Field: No Fields 1 Square Feet 1200 Linear Feet 400
No Lines 3@84' Trench Width 36" Max Trench Bottom Depth 36"

X New System ☐ Repair System Type: I, (II), III, IV, V, VI
System Description: Gravity Conv.
Repair System Description: Same
Maintenance Agreement Required: ☐ Yes ☒ No
Gravel Depth 12" ☐ Slab ☒ Crawl Space ☐ Basement w/plumbing ☐ Basement wo/plumbing


☐ House/Mod. Home No. Bedrooms 3
☒ Mobile Home No. Bathrooms 2
☐ Business No. Employees _____
☐ Other _____

Water Supply: ☒ Individual ☐ Public ☐ Community


Comments/Conditions: Keep well 100' from septic system.

Comments/Conditions: Poly lock Filter Installed

INITIAL SITE SKETCH

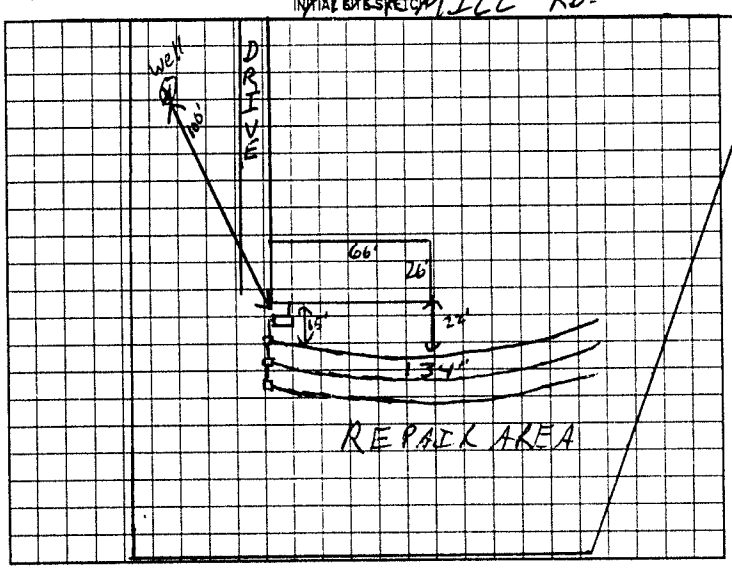

AS BUILT SKETCH

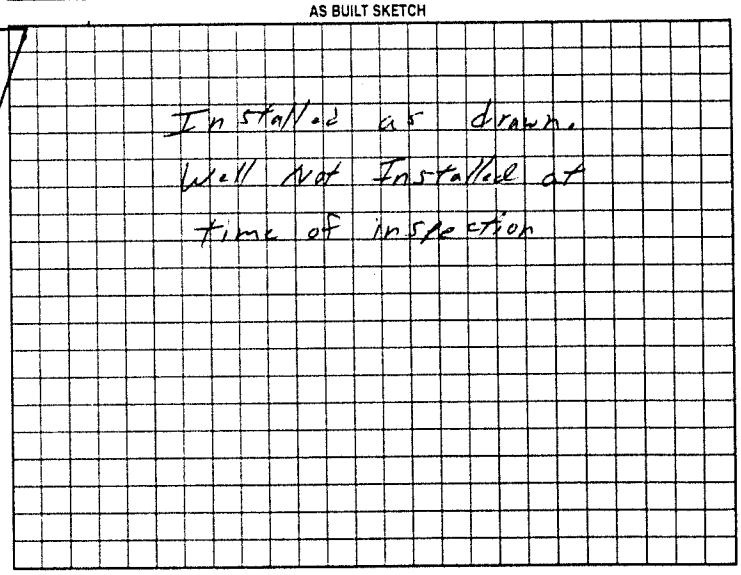

Permit can be suspended or revoked if any false information is supplied toward securing the permit/any unauthorized changes are made to the site/any unauthorized changes are made in the installation of the system. Improvement Permit with plat valid without expiration. Improvement Permit with site plan valid for sixty months. Authorization to Construct is valid for a period equal to that of Improvement Permit – not to exceed sixty months.

Signed: Melvin Johnson date 10/25/00 Installed by: Tommy Cothran

Improvement Permit by: RSI date 10/25/00 Operation Permit by: RSI date 11/3/00

Authorization to Construct by: RSI date 10/23/00 Existing System Inspection by: _____ date _____

HEALTH DEPT. COPY WHITE OWNER COPY (FINAL) YELLOW OWNER COPY (INITIAL) PINK