IREDELL COUNTY HEALTH DEPARTMENT

Statesville Office (704) 878-5305 | Mooresville Office (704) 660-3625 | PERMIT # 210218

IMPROVEMENT PERMIT / AUTHORIZATION TO CONSTRUCT / OPERATION PERMIT / EXISTING SYSTEM

PIN # 3793815466

APPLICANT: Robert Crawford | APPLICANT ADDRESS: 124 Buck Hollow Rd Statesville NC

SITE ADDRESS: 124 Buck Hollow Rd Statesville NC | PHONE: 704-871-7167 | ALT. PHONE: N/A

SITE DIRECTIONS: 3 miles west at old Mtn Rd on US 70 T/R Deer Trail T/R Buck hollow House on right

SUBDIVISION: N/A | SECTION: N/A | LOT # N/A | LOT AREA: 2.250 ac | DESIGN FLOW: Ex | L.T.A.R.: Ex

Septic Tank Ex (gal) | STB | Date
Pump Tank (gal) | PT | Date
Pump Make | Model | Serial #
Nitrification Fields Ex | # Lines 6x | Linear Ft: 6x
Trench Width Ex | Max. Trench Bottom Depth 6x | Gravel Depth 6x


☐ New System ☐ Repair ☐ Expansion System Type: I II III IV V VI
System Description: Existing
Repair System Description:
Maintenance Agreement Required: ☐ YES ☒ NO
☒ GRAVITY ☐ PRESSURE

☒ Residence | No. Bedrooms Ex
☐ Business | No. Persons Ex
☐ Other | No. Employees
☐ Slab | ☒ Crawl Space
☐ Basement w/plumbing | ☐ Basement w/o plumbing


Water Supply: ☐ Private ☑ Public ☐ Community

Comments / Conditions: All building foundations must be 35 from any part of SIS

INITIAL SITE SKETCH

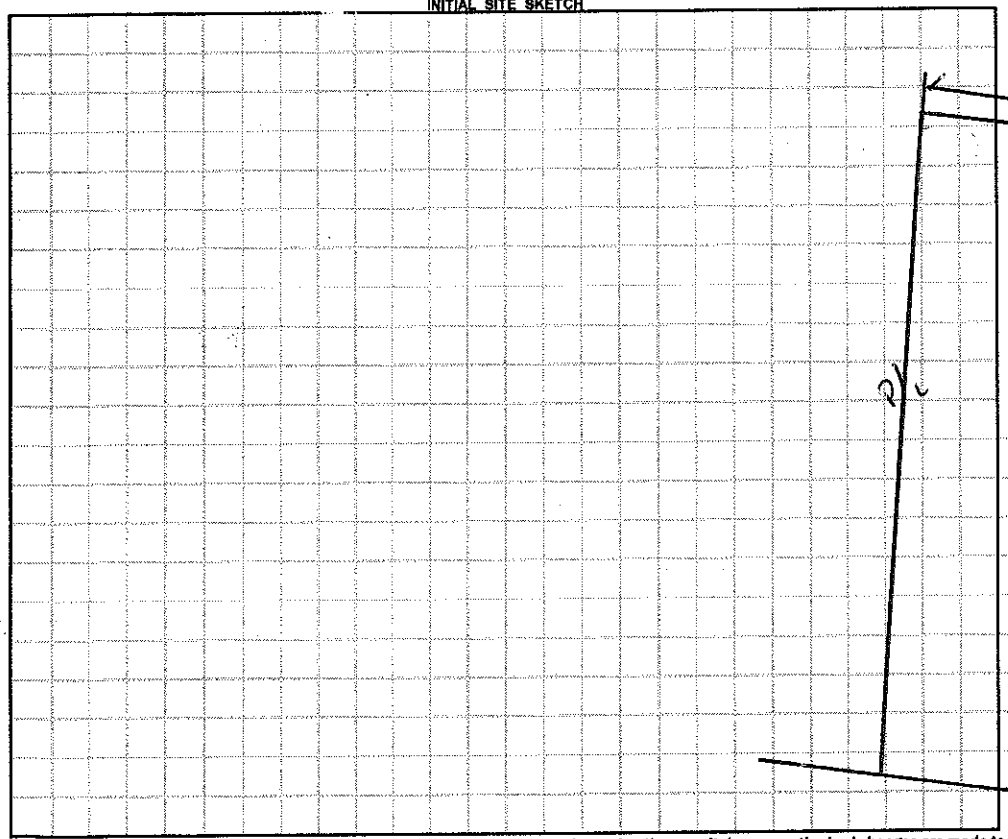

AS BUILT SKETCH

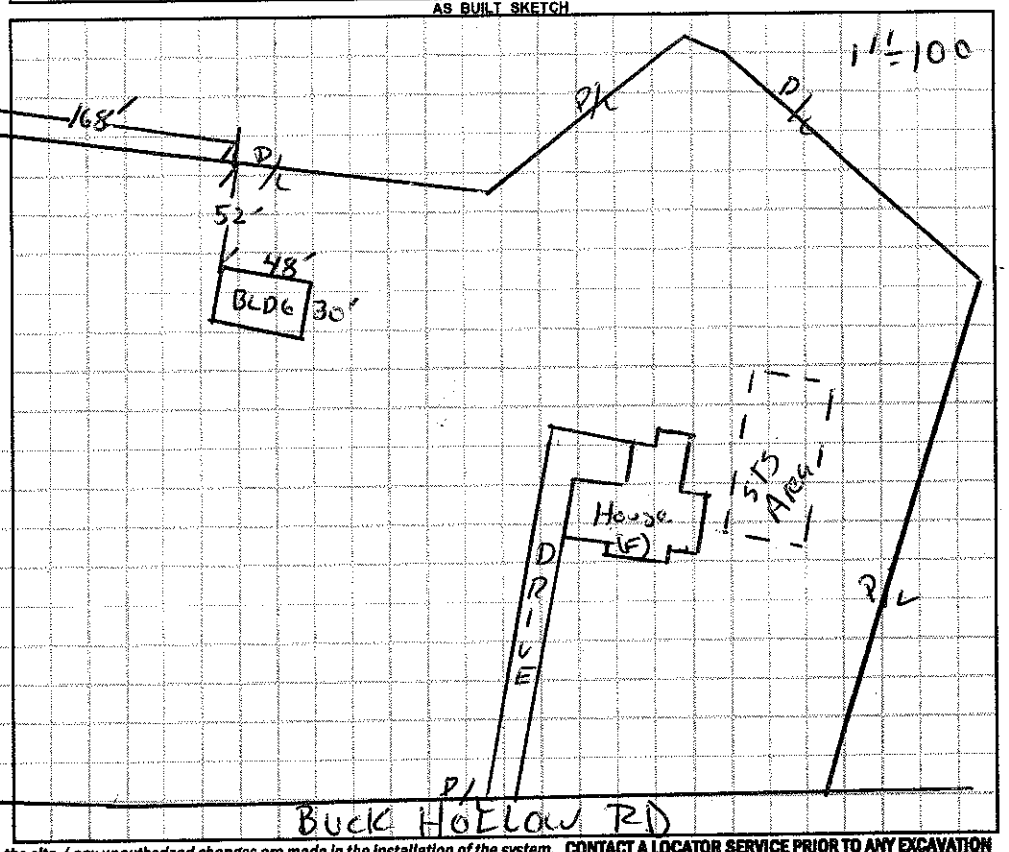

Permit can be suspended or revoked if any false information is supplied toward securing the permit / any unauthorized changes are made to the site / any unauthorized changes are made in the installation of the system. **CONTACT A LOCATOR SERVICE PRIOR TO ANY EXCAVATION**

☐ **IMPROVEMENT PERMIT** *with plat valid without expiration.* ☐ **IMPROVEMENT PERMIT** *with site plan valid for 60 mos.* ☐ **AUTHORIZATION TO CONSTRUCT** *valid for period equal to IMPROVEMENT PERMIT--not to exceed 60 mo.*

Owner / Applicant Signature: Robert Crawford | Date: 6-1-15 | Installed by:

IMPROVEMENT PERMIT by: | Date: | OPERATION PERMIT by: | Date:

AUTHORIZATION TO CONSTRUCT by: | Date: | Existing System Inspected by: David A Lee | Date: 05/29/15

Health Dept. Copy - WHITE Applicant (Final Approval) - YELLOW Applicant (Conditional Approval) - PINK