IREDELL COUNTY HEALTH DEPARTMENT - *ENVIRONMENTAL HEALTH* ☐ STATESVILLE OFFICE 704-878-5305 ☐ MOORESVILLE OFFICE 704-664-5281

IMPROVEMENT PERMIT / AUTHORIZATION TO CONSTRUCT / OPERATION PERMIT / EXISTING SYSTEM INSPECTION

PERMIT # 171928 PIN # 3793-81-9395 DATE MAY 8, 2012

OWNER KENNETH JAMES APPLICANT: SAME PHONE: Home/Cell # 704-924-6822 Business # 704-818-7303

SITE ADDRESS 3746 HICKORY HIGHWAY OWNER / APPLICANT ADDRESS SAME

SITE DIRECTIONS US 70 WEST, ON RIGHT AT BOX # 3746

SUBDIVISION NA BLOCK / SECTION NA LOT # NA LOT AREA 2.209 Acres DESIGN FLOW 240 L.T.A.R. EXISTING

Septic Tank EX Gallons: STB Date

Pump Tank Gallons: P T Date

Pump Make Model Serial #

No. Nitrification Fields: 1 No. Lines 1 Linear Feet ~75'

Trench Width 60 Max. Trench Bottom Depth 60 Gravel Depth N/A

☐ New System ☐ Repair ☐ Expansion System Type I / II / III / IV / V / VI

System Description: CONVENTIONAL GRAVITY

Repair System Description:

Maintenance Agreement Required ☐ YES ☒ NO

☒ GRAVITY ☐ PRESSURE

☒ Residence No. Bedrooms 2

☐ Business No. Persons

☐ Other No. Employees

☐ Slab ☐ Crawl Space


☒ Basement w/plumbing ☐ Basement w/o plumbing

Water Supply
☐ Private
☒ Public
☐ Community


Comments / Conditions

EXISTING SYSTEM APPEARS TO BE COMPRISED OF A CONCRETE SEPTIC TANK & ONE DRAIN LINE of CINDERS & SAND DRAINING IN A POSSIBLE CESSPOOL AFTER APPROXIMATELY 75 FEET.

INITIAL SITE SKETCH

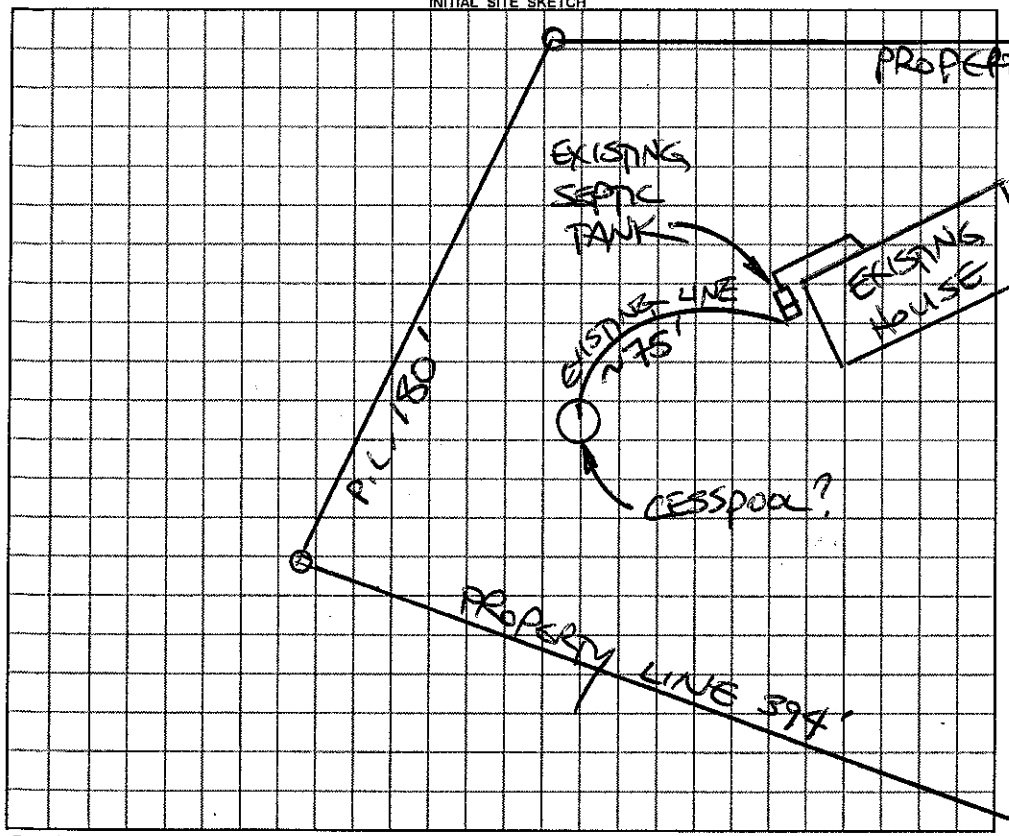

AS BUILT SKETCH

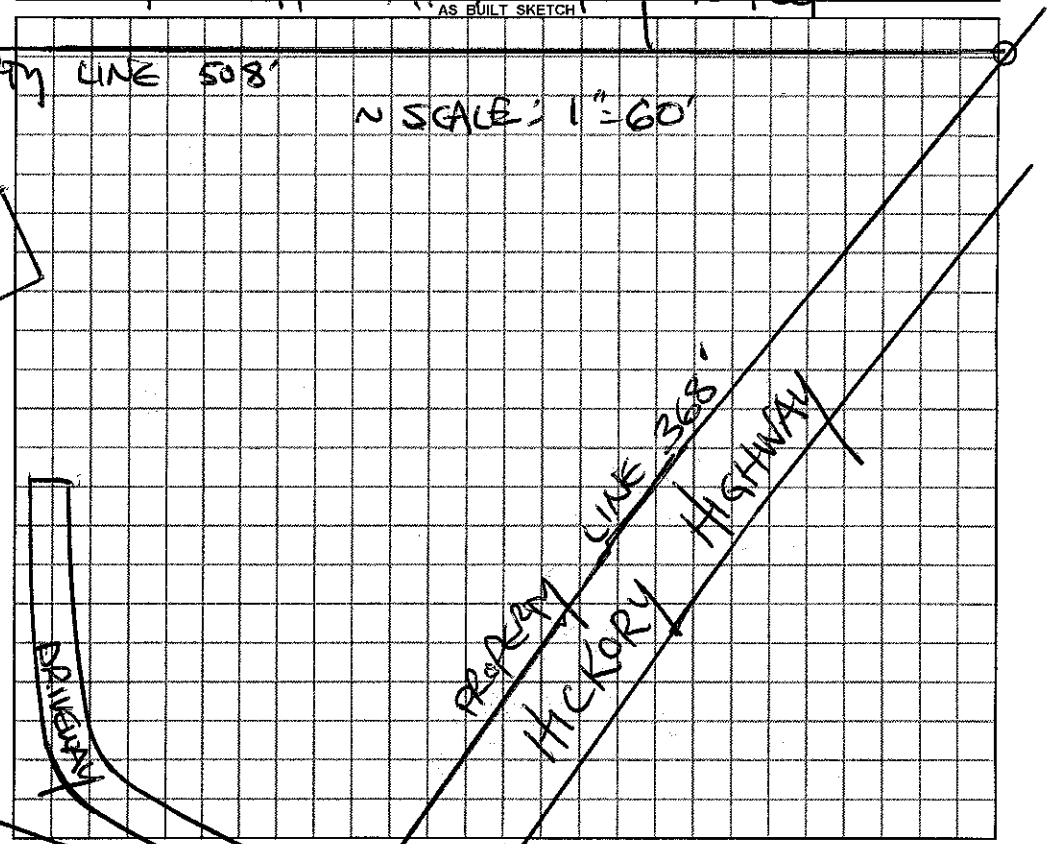

Permit can be suspended or revoked if any false information is supplied toward securing the permit / any unauthorized changes are made to the site / any unauthorized changes are made in the installation of the system.

☐ ***IMPROVEMENT PERMIT*** *with plat valid without expiration.* ☐ ***IMPROVEMENT PERMIT*** *with plat valid without expiration.* ~~site plan valid 60 mo.~~ ☒ ***AUTHORIZATION TO CONSTRUCT*** valid for period equal to IMPROVEMENT PERMIT–not to exceed 60 mo.

Owner / Applicant Signature: Date Installed by:

IMPROVEMENT PERMIT by: REHS Date OPERATION PERMIT by: REHS Date

AUTHORIZATION TO CONSTRUCT by: REHS Date Existing System Inspected by: STEVE HEDRICK REHS Date 5/8/12

YOU SHOULD CONTACT A LOCATOR SERVICE PRIOR TO ANY EXCAVATION

White Copy – Environmental Health YELLOW COPY (Final) Owner / Applicant PINK COPY (Initial) Owner / Applicant