IREDELL COUNTY HEALTH DEPARTMENT

STATESVILLE 704-878-5305 MOORESVILLE 704-664-5281

IMPROVEMENT PERMIT / AUTHORIZATION TO CONSTRUCT / OPERATION PERMIT / EXISTING SYSTEM INSPECTION

* RepDIR Permit # 171792 attached for deck addition 4-4-12. AL

PERMIT # RepDIR PIN # 3793-91-0525 DATE 17 September 10

OWNER or APPLICANT John Z. IKA PHONE: Business Home: (704) 871-9858

OWNER or APPLICANT ADDRESS 3732 Hickory Hwy Statesville, N.C.

LOCATION / DIRECTIONS Old Mtn. Rd. Turn onto Hwy 70 W 2 1/2 miles on Rt.

SUBDIVISION BLOCK / SECTION LOT # LOT AREA 2.37ac. DESIGN FLOW 480 gpd L.T.A.R. 0.3/HTL

Septic Tank 1000 Gallons: STB 1012 Date 10-11-10

Pump Tank Gallons: P T Date

Pump Make Model Serial #

Nitrification Field No Fields 1 No Lines 5 Linear Feet 400

Trench Width 36" Max. Trench Bottom Depth 36" Gravel Depth NA

☐ New System ☑ Repair ☐ Expansion System Type I II III IV V VI

System Description:

Repair System Description: 25% Reduction

Maintenance Agreement Required ☐ YES ☒ NO

☐ GRAVITY ☐ PRESSURE

☐ Residence No. Bedrooms 4

☐ Business No. Persons

☐ Other No. Employees

☐ Slab ☐ Crawl Space


☑ Basement w/plumbing ☐ Basement w/o plumbing

Water Supply: ☐ Private ☑ Public ☐ Community


Comments / Conditions * Crossing vehicle drive shall be greater than 30" in depth or constructed of ductile iron.

Comments / Conditions Polyluck filter / Septic tank has marker.

INITIAL SITE SKETCH

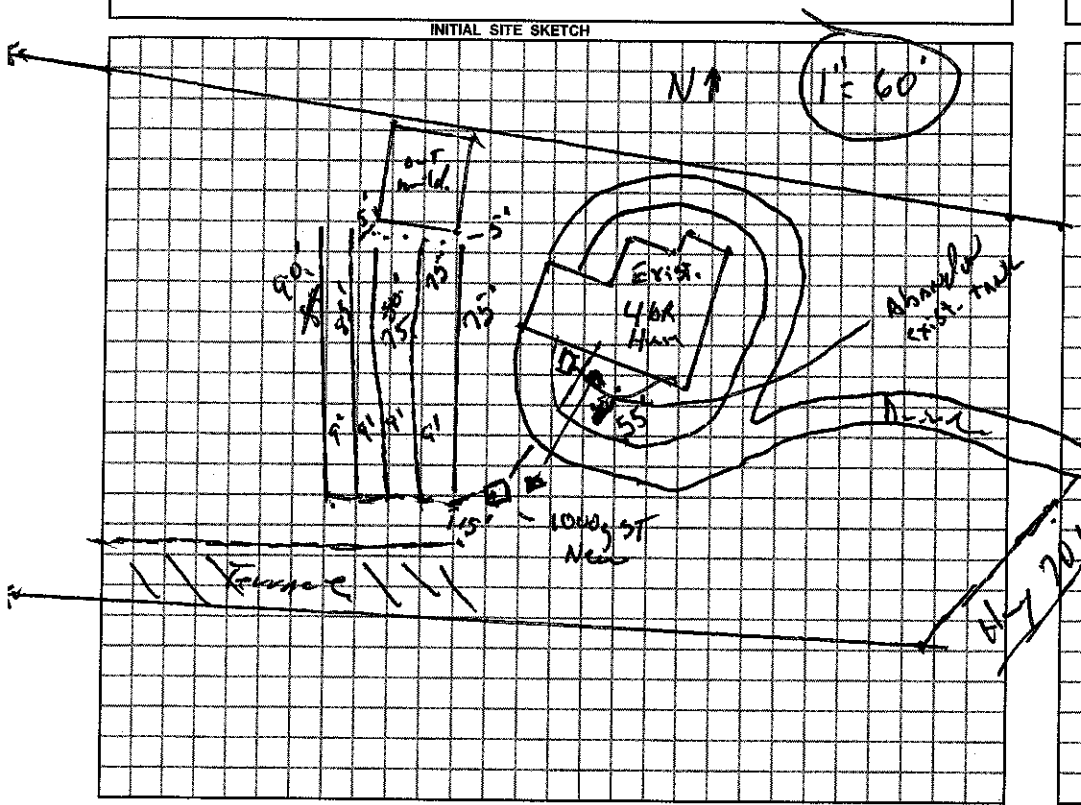

AS BUILT SKETCH

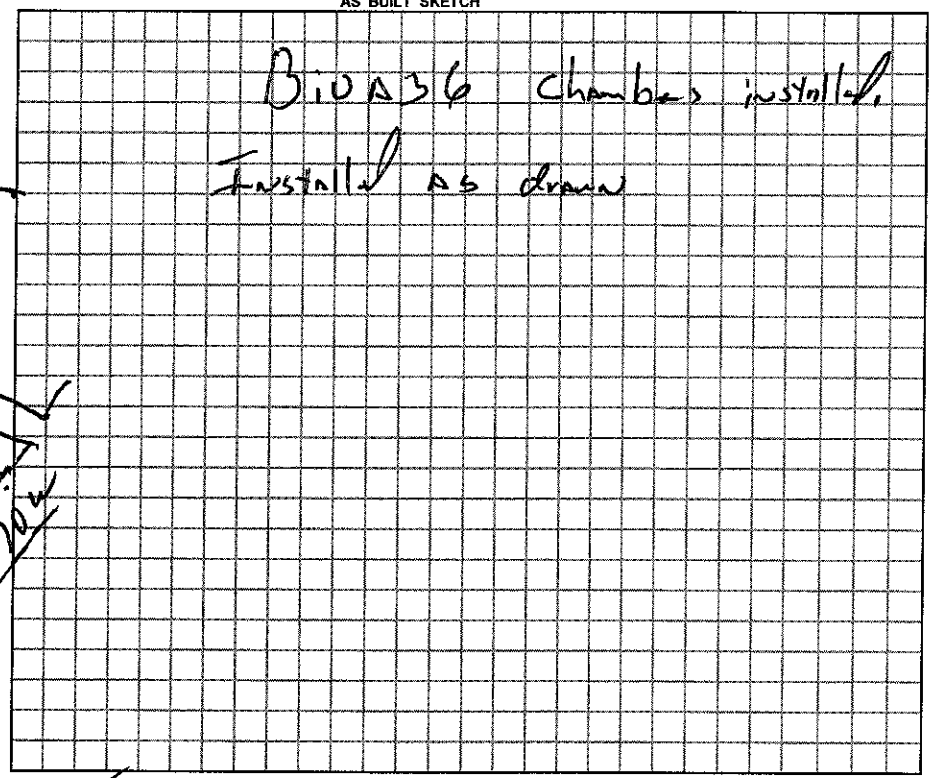

Permit can be suspended or revoked if any false information is supplied toward securing the permit / any unauthorized changes are made to the site / any unauthorized changes are made in the installation of the system.

☐ *IMPROVEMENT PERMIT w / plat valid without expiration.* ☑ *IMPROVEMENT PERMIT w / site plan valid for 60 mos.* ☑ *AUTHORIZATION TO CONSTRUCT valid for period equal to IMPROVEMENT PERMIT-not to exceed 60 mo.*

Owner / Applicant Signature: Karen P. Ika Date 9-23-2010

Improvement Permit by: , R.S. Date 21 Sept. 10

Authorization to Construct by: , R.S. Date 21 Sept. 10

Installed by: Ground Aquaculture

Operation Permit by: , R.S. Date: 14 July 11

Existing System Inspected by: Date:

YOU SHOULD CONTACT A LOCATOR SERVICE PRIOR TO ANY EXCAVATION.

WHITE COPY Environmental Health YELLOW COPY (Final) Owner / Applicant PINK COPY (Initial) Owner / Applicant