IREDELL COUNTY HEALTH DEPARTMENT

Statesville Phone TR 3-7271 Mooresville Phone NO 3-1271

PERMIT TO INSTALL SEPTIC TANK

Permit NO. _____ Poole lot Permit Date April 30 1964

Owner Parks Stewart Address Rt. 3 - Hickory Hwy.

Installed By C Hoke Address R7


Location of Property trailer on Right past old Hill top Sch - Wilson Hill - across from Miller Fabric Shop

Tank		Capacity		Length of Lines		Fixtures	
Block	( )	1000	( )	225'	( )	No. of Baths	( )
Precast	( )	1250	( )	250'	( )	Dishwasher	( )
		1500	( )	Other _____		Garbage Grdr.	( )
		Other _____				Other _____	

NOTIFY HEALTH DEPARTMENT AT LEAST EIGHT HOURS BEFORE TANK IS TO BE INSPECTED.

Final Inspection 4-30 1964 Approved ( ) Disapproved ( )

Remarks well 53' Pd.

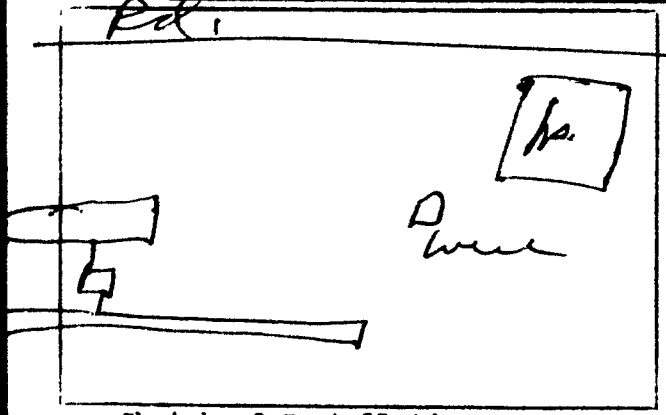

Sketch of Installation

Sanitarian