8H-A- PT 53

58424

IREDELL COUNTY HEALTH DEPARTMENT

STATESVILLE 704-878-5305 MOORESVILLE 704-664-5281

IMPROVEMENT PERMIT / CERTIFICATE OF COMPLETION / OPERATION PERMIT / EXISTING SYSTEM INSPECTION

PROPERTY DESCRIPTION NO. 21705 DATE 10-11-95 TAX MAP NO. 8H-A-53 (PART OF) Watershed: ☐ Yes ☑ No

OWNER OR CONTRACTOR JAMES C. GEISLER PHONE: Business Home 873-4199

ADDRESS 3697 HICKORY HWY, STATESVILLE, NC 28677

LOCATION US 70 WEST, 2ND DWELLING ON LEFT PAST MILLER'S FABRIC SHOP

SUBDIVISION BLOCK / SECTION LOT LOT AREA 1.50 Ac SITE CLASS. PS DESIGN FLOW 360 L.T.A.R. 0.30 GPD/FT

Septic Tank: 1000 Gallons; STB 794 Date 7/22/95

Pump Tank: Gallons; PT Date

Pump Make: Model Serial No.

Nitrification Field: No Fields 1 Square Feet 1200 Linear Feet 400

No Lines 5 Trench Width 36" Max Trench Bottom Depth 20"-24" Gravel Depth 12"

☑ New System ☐ Repair System Type: I II III IV V VI

System Description: CONV. SHALLOW GRAVITY FED

Repair System Description: LOW PRESSURE PIPE

Maintenance Agreement Required: ☐ Yes ☑ No

☐ House/Mod. Home ☑ Mobile Home ☐ Business ☐ Other

No. Bedrooms 3 No. Bathrooms 2½ No. Employees


☐ Slab ☑ Crawl Space ☐ Basement w/plumbing ☐ Basement wo/plumbing

Water Supply: ☐ Individual ☐ Community ☑ Public


Comments: ① KEEP SYSTEM MINIMUM 5' FROM BUILDING FOUNDATION, 10' FROM PROPERTY LINE ② INSTALL LINES ON CONTOUR, NO DEEPER THAN 24" c/l MINIMUM APART ON CENTERS.

Comments:

INITIAL SITE SKETCH

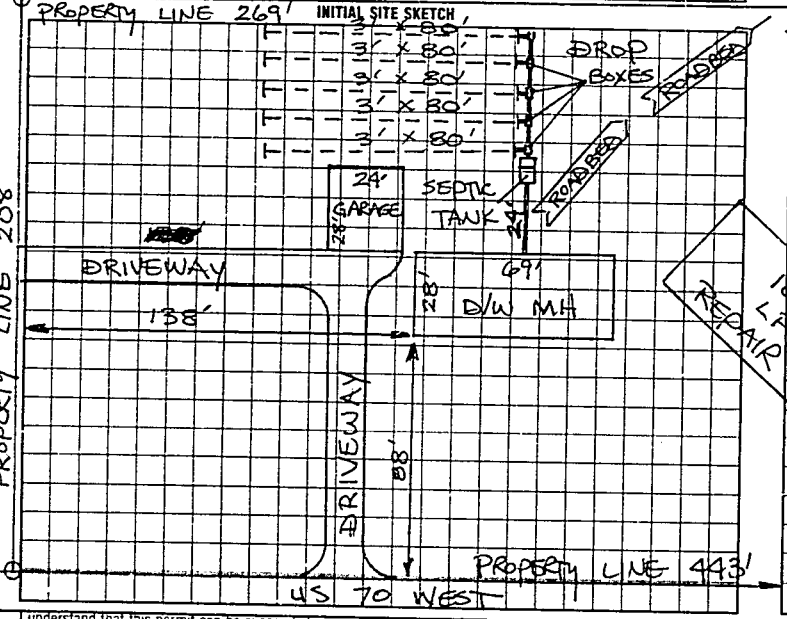

AS BUILT SKETCH

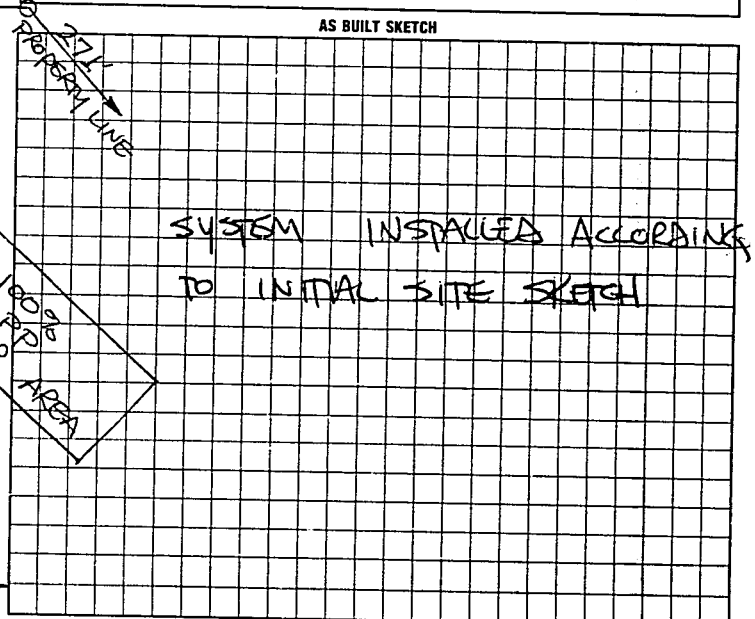

I understand that this permit can be suspended or revoked if any false information is supplied toward securing the permit/any unauthorized changes are made to the site/any unauthorized changes are made in the installation of the system.

AUTHORIZATION TO CONSTRUCT IS VALID FIVE (5) YEARS FROM DATE OF ISSUANCE. IMPROVEMENT PERMIT HAS NO EXPIRATION DATE.

Signed: X Travis E May

Improvement Permit by: STEVE HEDRICK date 10-11-95

~~Authorization~~ AUTHORIZATION TO CONSTRUCT BY: STEVE HEDRICK date 10-11-95

Installed by: ANDY DANIELS

~~Operation Permit by:~~ date

Operation Permit by: STEVE HEDRICK date 12-13-95

HEALTH DEPT. COPY: WHITE INSPECTION COPY (FINAL): GREEN OWNER COPY (FINAL): YELLOW INSPECTION COPY (INITIAL): PINK OWNER COPY (INITIAL): GOLD