IREDELL COUNTY HEALTH DEPARTMENT

Statesville Phone TR 3-7271 Mooresville Phone NO 3-1271

PERMIT TO INSTALL SEPTIC TANK

Permit NO. _____ Permit Date 11-17-54 195__

Owner Carlie Forsyth Address 64 West

Installed By CLYDE HOKE Address _____


Location of Property past Miller Fabric shop at Hilltop Ser. Sta left on 64 drive 1st on left. 1 block off Rd

Tank		Capacity		Length of Lines		Fixtures	
Block	( )	800	( )	150'	( )	No. of Baths	(✓)
Precast	(2)	900	(✓)	175'	( )	Dishwasher	( )
		1000	( )	200'	( )	Garbage Grdr.	( )
		1100	( )	225'	(✓)	Auto-Washer	(✓)
		1200	( )	250'	( )	Other	
		Other		Other			

NOTIFY HEALTH DEPARTMENT AT LEAST EIGHT HOURS BEFORE TANK IS TO BE INSPECTED.

Final Inspection 11-17-54 195__ Approved ( ) Disapproved ( )

Remarks self appr- well 50'

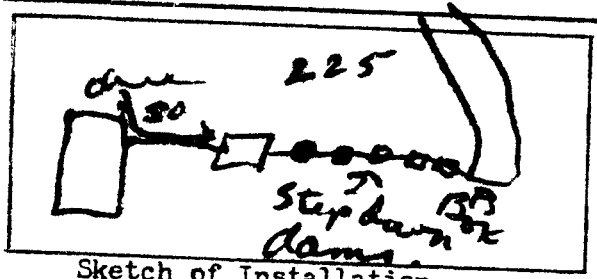

Sketch of Installation

Rut.

Sanitarian