Expansion [100 CBJ

<1

IREDELL COUNTY HEALTH DEPARTMENT

STATESVILLE 704-878-5305 MOORESVILLE 704-664-5281

IMPROVEMENT PERMIT / AUTHORIZATION TO CONSTRUCT / OPERATION PERMIT / EXISTING SYSTEM INSPECTION

PERMIT# 147050 PIN# 3793-71-3999 927006 DATE 9 Jan-08

OWNER OR APPLICANT David Poole PHONE: Business Home 704-873-4852

ADDRESS 142 Cedar Hill Ln. Statesville, N.C.

LOCATION 0m 12 - T on Hickory Hwy - First House past Hearthstone on Rt. 120

SUBDIVISION BLOCK / SECTION LOT LOT AREA 1.5 Ac. SITE CLASS. PS DESIGN FLOW 300 gpd L.T.A.R. 0.33 gpd/ft²

Septic Tank: 1000g Gallons: STB 1000 Date 11-19-07

Pump Tank: Gallons: PT Date

Pump Make: Model Serial No.

Nitrification Field: No Fields 1 Square Feet Add 400 Linear Feet 100

No Lines 2 Trench Width 36" Max Trench Bottom Depth 24"

☐ New System ☐ Repair ☑ Expansion System Type: I II III IV V VI

System Description: 25% Reduction

Repair System Description: 25% Reduction - pump

Maintenance Agreement Required: ☐ Yes ☒ No

☐ House/Mod. Home No. Bedrooms 3

☐ Mobile Home No. Persons

☐ Business No. Employees

☐ Other

Water Supply: ~~Individual~~ ~~Public~~ ☐ Community

Gravel Depth ☐ Gravity ☐ Pressure ☐ Slab ☑ Crawl Space ☐ Basement w/plumbing ☐ Basement wo/plumbing


Comments:/Conditions:

Add new 1000g ST and 400ft² of 25% Reduction system to exist. system / well Abandonment Record Attached.


Comments:/Conditions:

Infl-1:2 Fill will

INITIAL SITE SKETCH

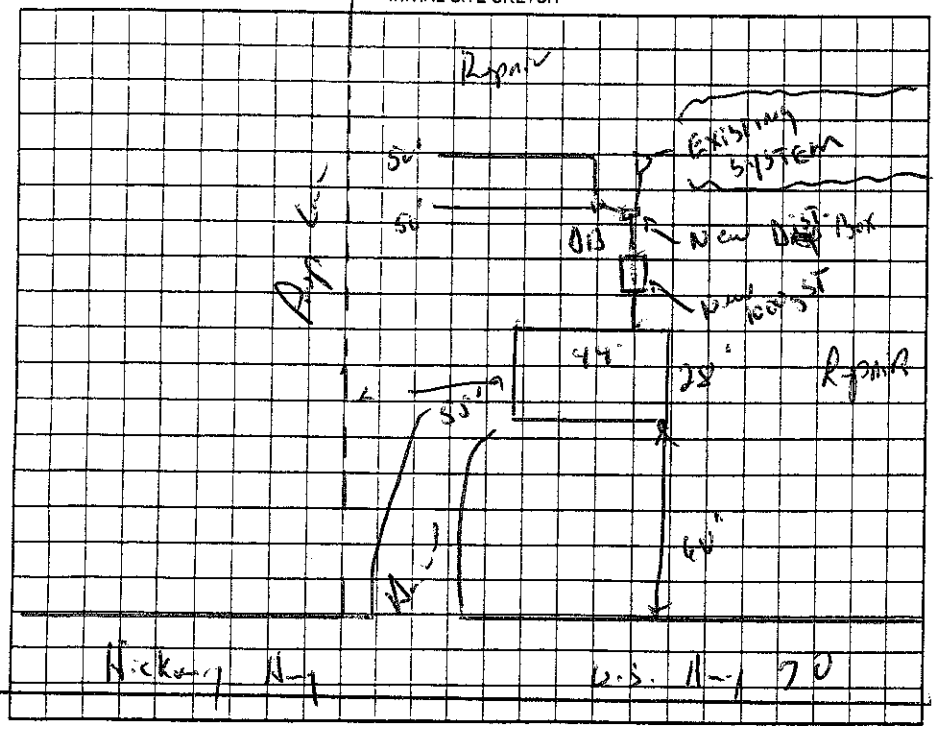

AS BUILT SKETCH

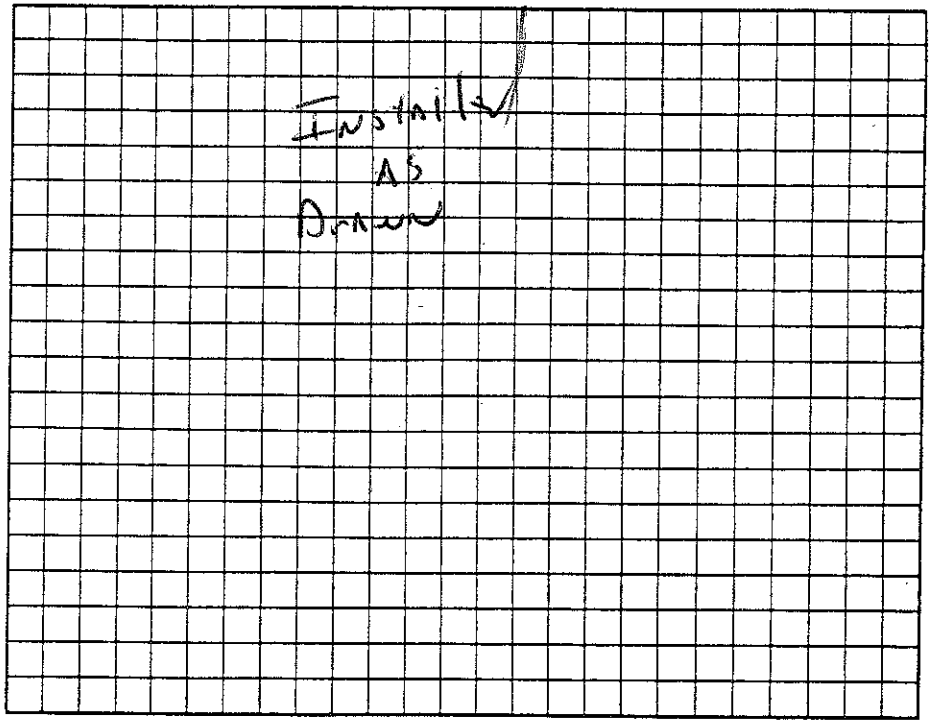

Permit can be suspended or revoked if any false information is supplied toward securing the permit/any unauthorized changes are made to the site/any unauthorized changes are made in the installation of the system. Improvement Permit with plat valid without expiration ☐ Improvement Permit with site plan valid for sixty months ☑ Authorization to Construct is valid for a period equal to that of Improvement Permit – not to exceed sixty months.

Signed: David M. Poole date

Improvement Permit by: J. Hayes, R.S. date 9 Jan. 08

Authorization to Construct by: J. Hayes R.S. date 9 Jan. 08

Installed by: Alexander Precast

Operation Permit by: J. Hayes, R.S. date 15 Jan 08

Existing System Inspection by: date

HEALTH DEPT. COPY: WHITE OWNER COPY (FINAL): YELLOW OWNER COPY (INITIAL): PINK