IREDELL COUNTY HEALTH DEPARTMENT

STATESVILLE 704-878-5305 MOORESVILLE 704-664-5281

IMPROVEMENT PERMIT / AUTHORIZATION TO CONSTRUCT / OPERATION PERMIT / EXISTING SYSTEM INSPECTION

PERMIT# 094841 PIN# 3793 96 3901 DATE 3/6/01

OWNER OR CONTRACTOR Southern Land + Dev. PHONE: Business (704) 876-1080 Home

ADDRESS 125 Greenfield Drive Statesville NC 28625

LOCATION 40W, (L) old mtn, (R) Bentah, (L) Mocks Mill, (R) Gold Leaf Corner on Left

SUBDIVISION Goldleaf BLOCK / SECTION — LOT 1 LOT AREA .47 SITE CLASS PS DESIGN FLOW 360 L.T.A.R. .3

Septic Tank: 4000 Gallons: STB 1012 Date 11-27-00
Pump Tank: Gallons: PT Date
Pump Make: Model Serial No.
Nitrification Field: No Fields 1 Square Feet 1200 Linear Feet 400
No Lines 3@133' Trench Width 36" Max Trench Bottom Depth 30" Gravel Depth 12"

X New System ☐ Repair System Type: I. II. III. IV. V. VI
System Description: Gravity, Conv.
Repair System Description: Pump, 25% Reduction
Maintenance Agreement Required: ☐ Yes X No

X House/Mod. Home ☐ Mobile Home ☐ Business ☐ Other
No. Bedrooms 3 No. Bathrooms 2 No. Employees


X Slab ☐ Crawl Space ☐ Basement w/plumbing ☐ Basement wo/plumbing

Water Supply: ☐ Individual X Public ☐ Community

Comments:/Conditions: (1) Remove Terraces before Installing lines (2) Install lines on contour (3) Keep Lines 10ft From Property Line (4) Use distribution box with Speed levelers

Comments:/Conditions: (1) SEPTIC TANK WITH MARKER INSTALLED USING "POLYLOK" FILTER (2) SYSTEM INSTALLED DEEP (72") DUE TO CONTOUR - SOIL CHARACTERISTICS OK

INITIAL SITE SKETCH

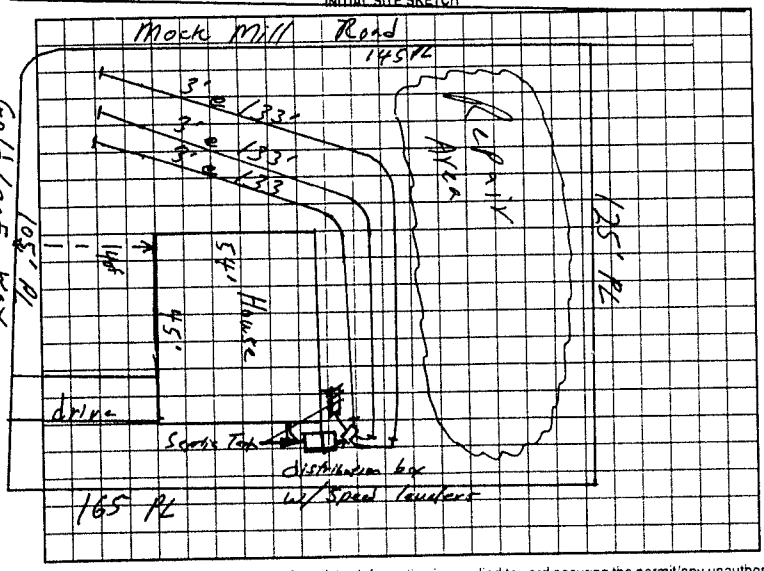

AS BUILT SKETCH

SYSTEM INSTALLED ACCORDING TO INITIAL SITE SKETCH

Permit can be suspended or revoked if any false information is supplied toward securing the permit/any unauthorized changes are made to the site/any unauthorized changes are made in the installation of the system. Improvement Permit with plat valid without expiration. Improvement Permit with site plan valid for sixty months. Authorization to Construct is valid for a period equal to that of Improvement Permit – not to exceed sixty months.

Signed: date 3-8-2001 Installed by: FORREST STAFFORD

Improvement Permit by: William O. Johnson RSI date 3/6/01 Operation Permit by: STEVE HEDRICK date 6-28-01

Authorization to Construct by: William O. Johnson RSI date 3/6/01 Existing System Inspection by: date

HEALTH DEPT. COPY: WHITE OWNER COPY (FINAL): YELLOW OWNER COPY (INITIAL): PINK