# IREDELL COUNTY HEALTH DEPARTMENT

STATESVILLE 704-878-5305 MOORESVILLE 704-664-5281

## IMPROVEMENT PERMIT / AUTHORIZATION TO CONSTRUCT / OPERATION PERMIT / EXISTING SYSTEM INSPECTION

PERMIT# 148262 PIN# 3793-96-~~5432~~ 4299 DATE 27 Feb. 08

OWNER OR APPLICANT Tony Boyd PHONE: Business 704-873-3339 Home 704-872-3533

ADDRESS 164 Buck Hollow Rd. Statesville N.C.

LOCATION Old Mtn Rd. Turn Beulah ch. Rd. - Turns into Mock Mill on RT before Benfield Rd

SUBDIVISION _____ BLOCK / SECTION _____ LOT _____ LOT AREA 1.08 ac. SITE CLASS. PS DESIGN FLOW 240 gpd L.T.A.R. .3 g/Ft²/d

Septic Tank: 1000 Gallons; STB 799 Date 3-25-08
Pump Tank: _____ Gallons; PT _____ Date _____
Pump Make: _____ Model _____ Serial No. _____
Nitrification Field: No Fields 1 Square Feet 800 Linear Feet 200
No Lines 4 Trench Width 36" Max Trench Bottom Depth 30"

☑ New System ☐ Repair ☐ Expansion System Type: I II (III) IV V VI
System Description: 25% Reduction
Repair System Description: 25% Reduction
Maintenance Agreement Required: ☐ Yes ☒ No
Gravel Depth _____ ☒ Gravity ☐ Pressure ☐ Slab ☒ Crawl Space ☐ Basement w/plumbing ☐ Basement wo/plumbing

☒ House/Mod. Home No. Bedrooms 2
☐ Mobile Home No. Persons ____
☐ Business No. Employees ____
☐ Other _____

Water Supply: ☐ Individual ☒ Public ☐ Community


Comments/Conditions: Follow contours / Honor setbacks
Do not cut or Fill over system AREA.

INITIAL SITE SKETCH

Please see Attached Layout design.

Comments/Conditions: Fill Install - ST Marker

AS BUILT SKETCH

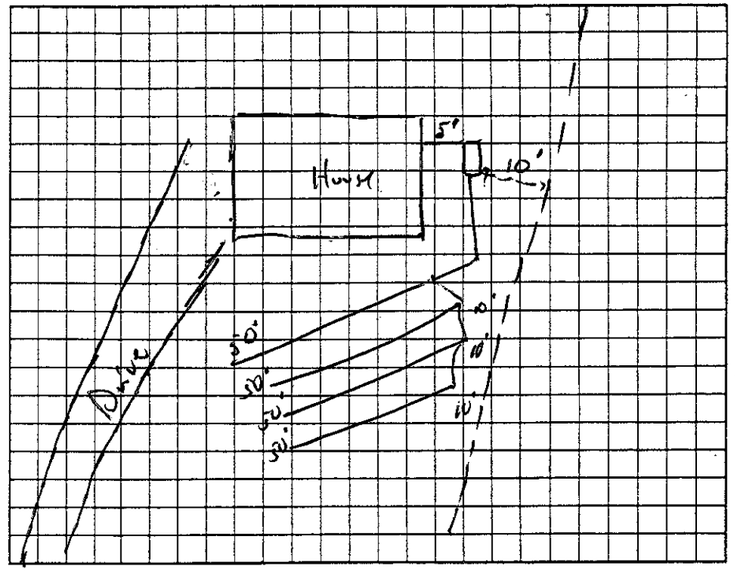



Permit can be suspended or revoked if any false information is supplied toward securing the permit/any unauthorized changes are made to the site/any unauthorized changes are made in the installation of the system. Improvement Permit with plat valid without expiration ☐ Improvement Permit with site plan valid for sixty months ☐ Authorization to Construct is valid for a period equal to that of Improvement Permit – not to exceed sixty months.

Signed: _____ date 2/27/08
Improvement Permit by: _____, R.S. date 27 Feb. 08
Authorization to Construct by: _____, R.S. date 27 Feb 08

Installed by: A-1 Backhoe
Operation Permit by: _____, R.S. date 30 April 08
Existing System Inspection by: _____ date _____

HEALTH DEPT. COPY: WHITE OWNER COPY (FINAL): YELLOW OWNER COPY (INITIAL): PINK

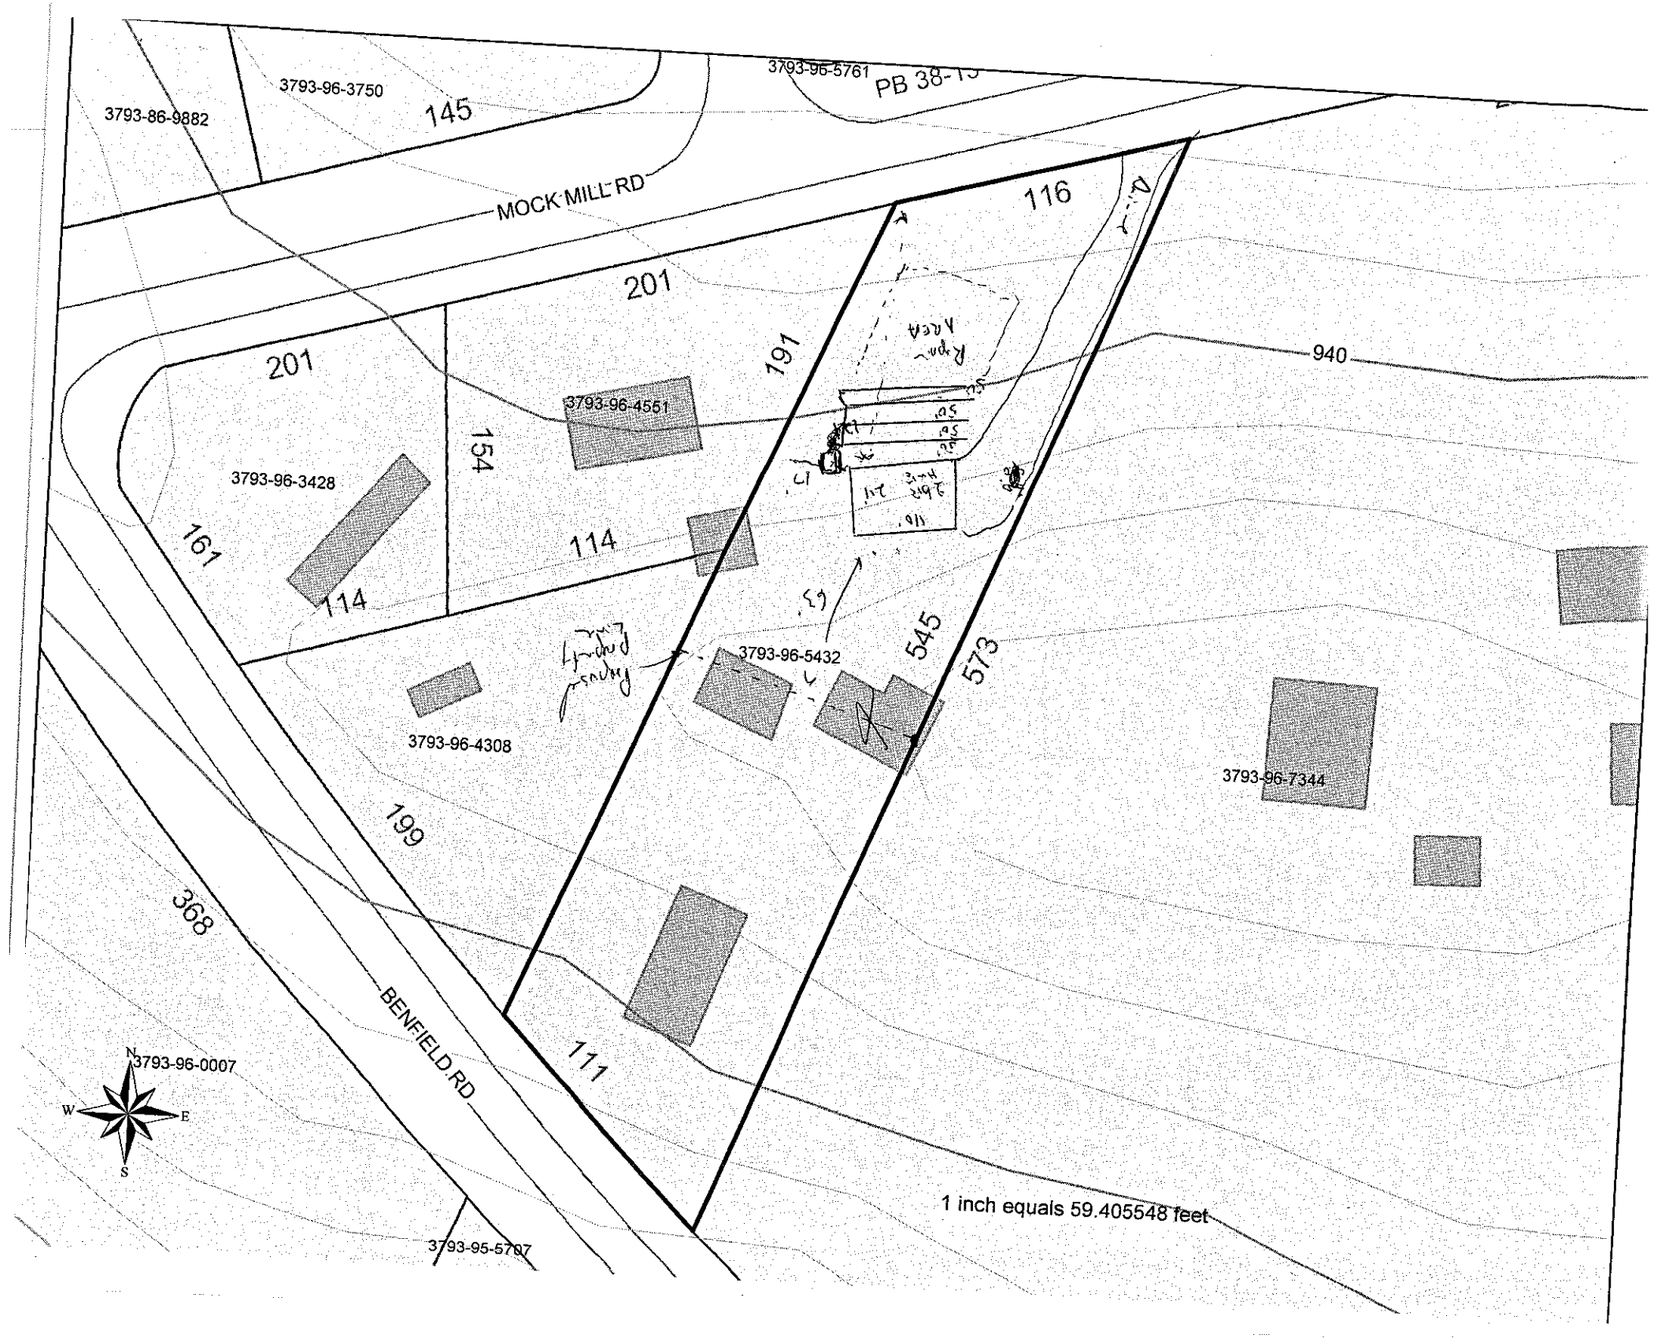
3793-86-9882
3793-96-3750
145
3793-96-5761
PB 38-15
MOCK MILL RD
116
201
201
191
940
3793-96-4551
154
3793-96-3428
161
114
114
3793-96-5432
545
573
3793-96-4308
3793-96-7344
199
368
BENFIELD RD
111
N
W
E
S
3793-96-0007
3793-95-5797
1 inch equals 59.405548 feet