IREDELL COUNTY HEALTH DEPARTMENT

STATESVILLE 704-878-5305 (c) MOORESVILLE 704-664-5281

IMPROVEMENT PERMIT / AUTHORIZATION TO CONSTRUCT / OPERATION PERMIT / EXISTING SYSTEM INSPECTION

PERMIT# 125039 PIN# 3793-96-5761 DATE 12-6-04

OWNER OR CONTRACTOR DEAN RICHON PHONE: Business 704-880-7444 Home 704-876-1080

ADDRESS 105 GOLD LEAF LANE, STATESVILLE, NC 28677

LOCATION OLD MOUNTAIN ROAD TO BEULAH ROAD, CONTINUE MOCK MILL ROAD, TR GOLD LEAF LANE, 1ST LOT ON RIGHT

SUBDIVISION GOLD LEAF BLOCK / SECTION ____ LOT 9 LOT AREA 0.475 ACRE SITE CLASS. PS DESIGN FLOW 360 L.T.A.R. 0.30 GPD/FT²

Septic Tank: 1000 Gallons; STB 1012 Date 12-7-04
Pump Tank: ____ Gallons; PT ____ Date ____
Pump Make: ____ Model ____ Serial No. ____
Nitrification Field: No. Fields 1 Square Feet EQ. T 1200 Linear Feet 300
No. Lines FIVE Trench Width 36" Max Trench Bottom Depth 36" Gravel Depth N/A

☑ New System ☐ Repair System Type: I, II, (III), IV, V, VI
System Description: 25% REDUCTION, GRAVITY
Repair System Description: 50% REDUCTION, LOW PRESSURE
Maintenance Agreement Required: ☐ Yes ☑ No


☑ House/Mod. Home No. Bedrooms 3
☐ Mobile Home No. Bathrooms ____
☐ Business No. Employees ____
☐ Other ____
☐ Slab ☑ Crawl Space ☐ Basement w/plumbing ☐ Basement wo/plumbing

Water Supply: ☐ Individual ☑ Public ☐ Community

Comments:/Conditions: INSTALL 25% REDUCTION SYSTEM ON CONTOUR AS SHOWN. REMOVE EXISTING FIELD TERRACE. KEEP SYSTEM MINIMUM 25' UP-SLOPE FROM EXISTING SUBSURFACE DRAIN

Comments:/Conditions: SEPTIC TANK WITH MARKER INSTALLED USING "TUFFITE" FILTER

INITIAL SITE SKETCH ~ SCALE: 1" = 40'

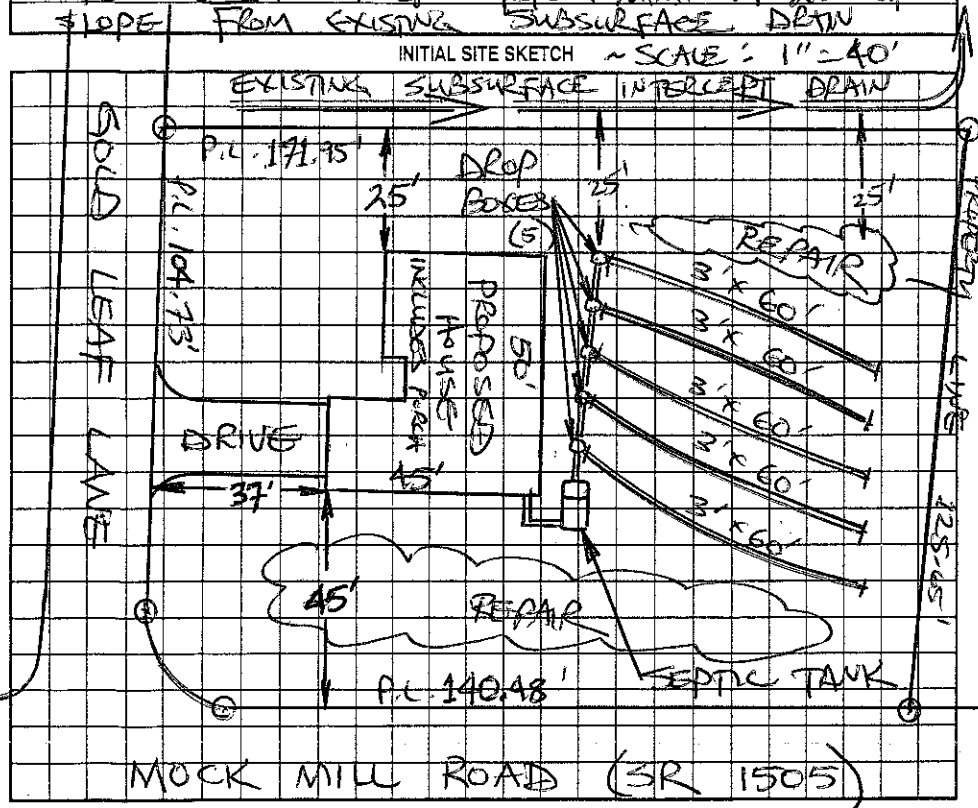

AS BUILT SKETCH

SYSTEM INSTALLED ACCORDING TO INITAL SITE SKETCH USING 75 "QUICK-4" INFILTRATOR CHAMBERS

Permit can be suspended or revoked if any false information is supplied toward securing the permit/any unauthorized changes are made to the site/any unauthorized changes are made in the installation of the system. Improvement Permit with plat valid without expiration. Improvement Permit with site plan valid for sixty months. Authorization to Construct is valid for a period equal to that of Improvement Permit – not to exceed sixty months.

Signed: ____ date 12-07-04 Installed by: FOREST SIMFORD

Improvement Permit by: STEVE HEDRICK date 12-6-04 Operation Permit by: STEVE HEDRICK date 6-17-05

Authorization to Construct by: STEVE HEDRICK date 12-6-04 Existing System Inspection by: ____ date ____

HEALTH DEPT. COPY: WHITE OWNER COPY (FINAL): YELLOW OWNER COPY (INITIAL): PINK