IREDELL COUNTY HEALTH DEPARTMENT

STATESVILLE 704-878-5305 (1) MOORESVILLE 704-664-5281

IMPROVEMENT PERMIT / AUTHORIZATION TO CONSTRUCT / OPERATION PERMIT / EXISTING SYSTEM INSPECTION

PERMIT# 130072 PIN# 3793-96-8828 DATE 8-8-05

OWNER OR CONTRACTOR DEAN RICHON PHONE: Business 704 880-7444 Home 704 876-1680

ADDRESS [redacted] 25 GREENFIELD DR Statesville, NC 28625

LOCATION 40 WEST @ SHARON SCHOOL @ MOCK MILL @ AFTER GOLDLEAF & BY Stewart DR

SUBDIVISION Stewart ACRES BLOCK / SECTION LOT 20 LOT AREA 1.03 AC SITE CLASS PS DESIGN FLOW 360 L.T.A.R. .35

Septic Tank: 1000 Gallons; STB 1012 Date 6-7-05
Pump Tank: Gallons; PT Date
Pump Make: Model Serial No.
Nitrification Field: No Fields 1 Square Feet 1440' Linear Feet 360'
No Lines 4 X 90' Trench Width 36" Max Trench Bottom Depth 24" DEEP SIDE 18" SHALLOW SIDE

[X] New System [ ] Repair System Type: I, (II), III, IV, V, VI
System Description: GRAV 2540 REDUCT
Repair System Description: SAME
Maintenance Agreement Required: [ ] Yes [X] No
Trench Depth N/A


[X] House/Mod. Home No. Bedrooms 3
[ ] Mobile Home No. Bathrooms 2
[ ] Business No. Employees
[ ] Other
[ ] Slab [X] Crawl Space [ ] Basement w/plumbing [ ] Basement wo/plumbing

Water Supply: [ ] Individual [X] Public [ ] Community

Comments/Conditions: (1) INSTALL FRENCH DRAIN 36" DEEP WITH FALL TO DAYLIGHT TO POINT SHOWN ON PERMIT (2) MAINTAIN 15' SIDE SETBACK FROM FRENCH DRAIN & SURFACE DIVERSION (3) with SLOPE SHALLOW SIDE OF DITCH


Comments/Conditions: WILL BE 18" DEEP & DEEP SIDE WILL BE 23½" DEEP. (4) USE SOLID SLOTTED PIPE UNDER DRIVE WITH GRAVEL (5) INSTALL LINES ON CONTOURS & MAINTAIN SETBACKS

INITIAL SITE SKETCH

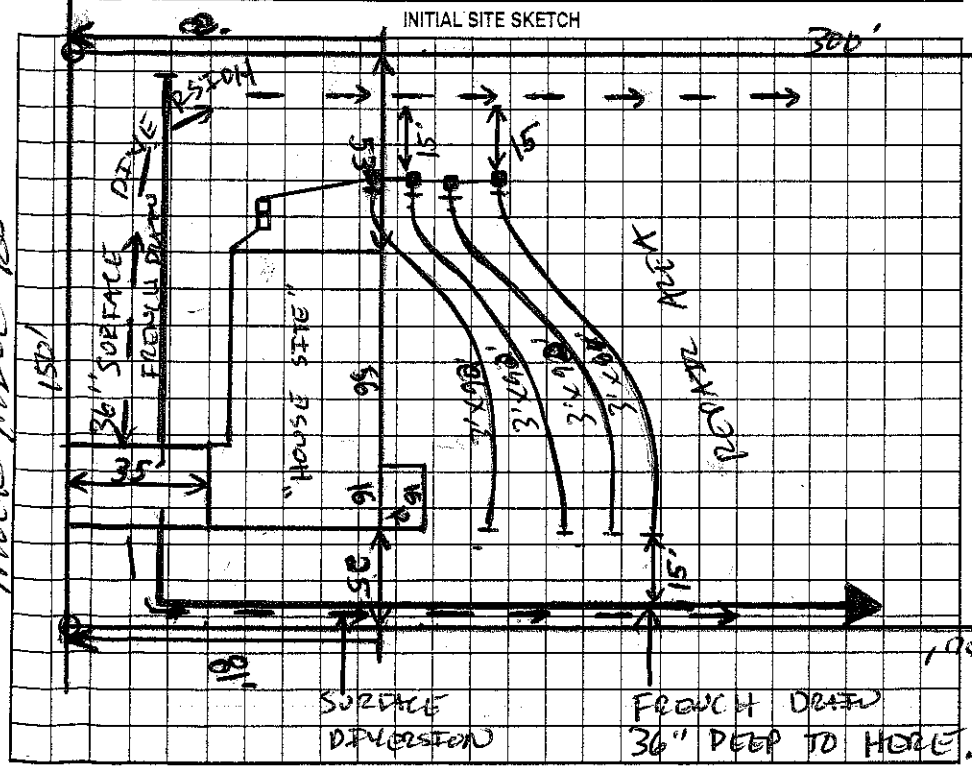

AS BUILT SKETCH

1" = 50'

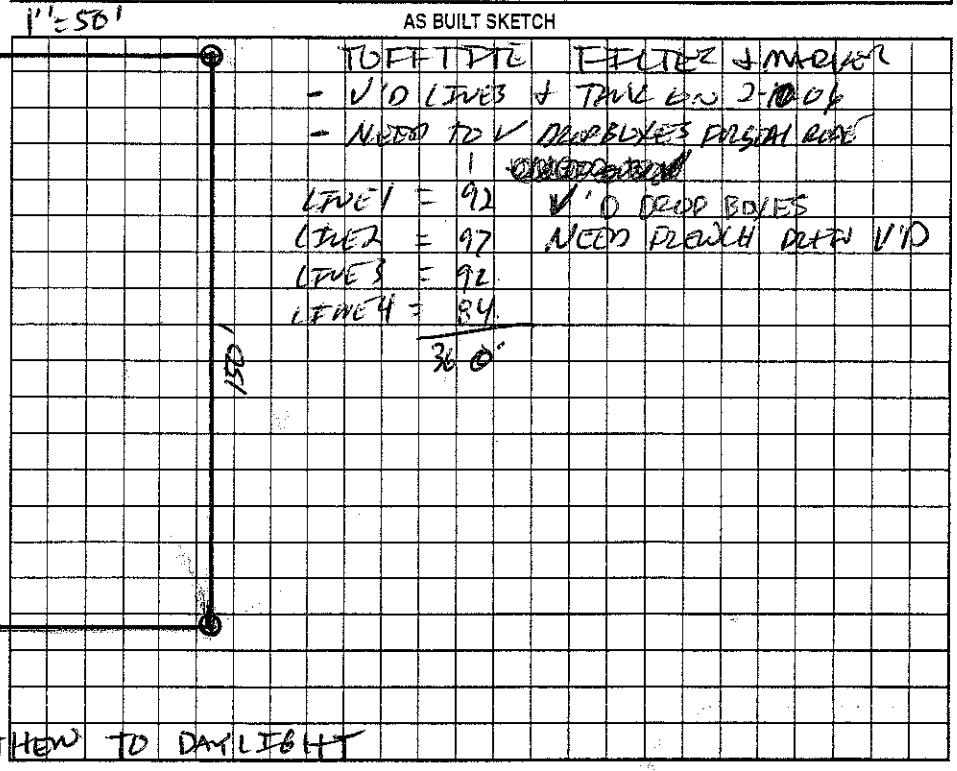

Permit can be suspended or revoked if any false information is supplied toward securing the permit/any unauthorized changes are made to the site/any unauthorized changes are made in the installation of the system. Improvement Permit with plat valid without expiration. Improvement Permit with site plan valid for sixty months. Authorization to Construct is valid for a period equal to that of Improvement Permit – not to exceed sixty months.

Signed: date 08-08-05 Installed by: FORREST SHUFFORD

Improvement Permit by: date 8-8-05 Operation Permit by: STEVE HENDRICK date 2-17-06

Authorization to Construct by: date 8-8-05 Existing System Inspection by: date

HEALTH DEPT. COPY: WHITE OWNER COPY (FINAL): YELLOW OWNER COPY (INITIAL): PINK