NEW PERMIT # 133890

IREDELL COUNTY HEALTH DEPARTMENT

STATESVILLE 704-878-5305 (C) MOORESVILLE 704-664-5281

IMPROVEMENT PERMIT / AUTHORIZATION TO CONSTRUCT / OPERATION PERMIT / EXISTING SYSTEM INSPECTION

PERMIT# 114278 PIN# 3793-97-2006.011 DATE 7-22-03

OWNER OR CONTRACTOR SOUTHERN LAND & DEVELOPMENT INC PHONE: Business 704-876-1080 Home

ADDRESS 119 GOLD LEAF LANE STATESVILLE NC 28677

LOCATION I-40 W, TL OLD MTN. RD, TR BEULAH RD, CONTINUE MOCK MILL RD TR GOLD LEAF LANE, 3RD ON LEFT

SUBDIVISION GOLD LEAF BLOCK / SECTION LOT 4 LOT AREA LIMITED SITE CLASS. PS DESIGN FLOW 360 L.T.A.R. 0.25 GPD/FT²

Septic Tank: 1000 Gallons; STB 9 10 1/2 Date 9-30-03

Pump Tank: 1000 Gallons; PT 17 Date 6-13-04

Pump Make: Model Serial No.

Nitrification Field: No Fields 1 Square Feet 440/440 Linear Feet 240

No Lines FIVE Trench Width 24" Max Trench Bottom Depth 36" ~~Gravel~~ Depth SAND 24"

☑ New System ☐ Repair System Type: I, II, III, IV, V, VI

System Description: 50% REDUCTION, PUMP

Repair System Description: 50% REDUCTION, LOW PRESSURE

Maintenance Agreement Required: ☐ Yes ☑ No

☑ House/Mod. Home No. Bedrooms 3

☐ Mobile Home No. Bathrooms 2

☐ Business No. Employees

☐ Other


☐ Slab ☑ Crawl Space ☐ Basement w/plumbing ☐ Basement wo/plumbing

Water Supply: ☐ Individual ☑ Public ☐ Community

Comments:/Conditions: ① INSTALL 50% REDUCTION SYSTEM ON CONTOUR USING 55 PPBPS PANELS AS SHOWN ② SEE ATTACHED SHEETS FOR PUMP & PRESSURE MANIFOLD REQUIREMENTS

Comments:/Conditions: SEPTIC TANK WITH MARKER INSTALLED USING "TUFTITE" FILTER

INITIAL SITE SKETCH

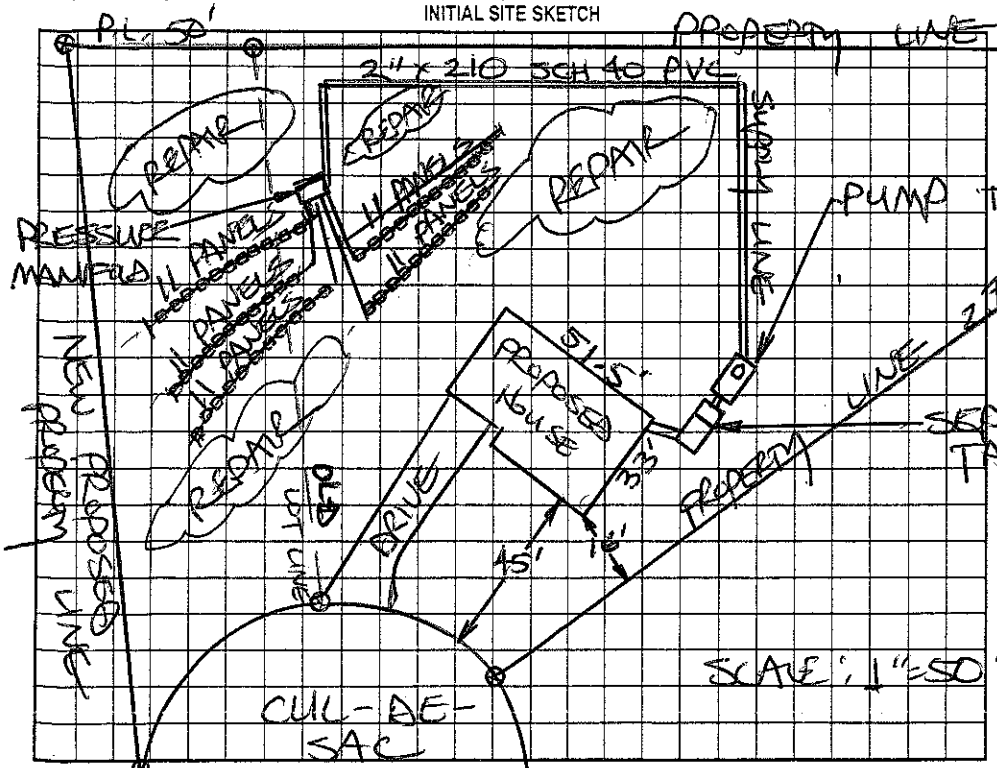

AS BUILT SKETCH

SYSTEM INSTALLED ACCORDING TO INITIAL SITE SKETCH

Permit can be suspended or revoked if any false information is supplied toward securing the permit/any unauthorized changes are made to the site/any unauthorized changes are made in the installation of the system. Improvement Permit with plat valid without expiration. Improvement Permit with site plan valid for sixty months. Authorization to Construct is valid for a period equal to that of Improvement Permit – not to exceed sixty months.

Signed: date 07-27-0 Installed by: FOREST STAFFORD

Improvement Permit by: STEVE HEDRICK date 7-22-03 Operation Permit by: STEVE HEDRICK date 2-15-2006

Authorization to Construct by: STEVE HEDRICK date 7-22-03 Existing System Inspection by: date

HEALTH DEPT. COPY: WHITE OWNER COPY (FINAL): YELLOW OWNER COPY (INITIAL): PINK