IREDELL COUNTY HEALTH DEPARTMENT

STATESVILLE 704-878-5305 MOORESVILLE 704-664-5281

IMPROVEMENT PERMIT / CERTIFICATE OF COMPLETION / OPERATION PERMIT / EXISTING SYSTEM INSPECTION

PROPERTY DESCRIPTION NO. 070187 DATE 10-29-97 TAX MAP NO. 3793 97 3375 Watershed: Yes ☑ No

OWNER OR CONTRACTOR NORMAN E. BENFIELD PHONE: Business Home 464-5039

ADDRESS 3609 BETHANY CHURCH ROAD, CLAREMONT NC 28610

LOCATION I-40 W TL OLD MTN. RD, TR MOCK MILL RD, TR STEWART ACRES, (2ND) LOT ON LEFT.

SUBDIVISION STEWART ACRES BLOCK / SECTION LOT 20 LOT AREA 1.374 ACRE SITE CLASS. PS DESIGN FLOW 360 L.T.A.R. 0.30 GPD/FT2

Septic Tank: 1000 Gallons; STB 821 Date 7-16-98

Pump Tank: Gallons; PT Date

Pump Make: Model Serial No.

Nitrification Field: No Fields 1 Square Feet 1200 Linear Feet 400

No Lines FOUR Trench Width 36" Max Trench Bottom Depth 36" Gravel Depth 12"

☑ New System ☐ Repair System Type: I, II, III, IV, V, VI

System Description: CONVENTIONAL GRAVITY

Repair System Description: CONV. GRAVITY

Maintenance Agreement Required: ☐ Yes ☑ No

☑ House/Mod. Home No. Bedrooms 3

☐ Mobile Home No. Bathrooms 2

☐ Business No. Employees

☐ Other


☐ Slab ☑ Crawl Space ☐ Basement w/plumbing ☐ Basement wo/plumbing

Water Supply:
☑ Individual
☐ Community
☐ Public
WELL


Comments: KEEP SYSTEM MINIMUM 100' FROM WELL

Comments:

INITIAL SITE SKETCH

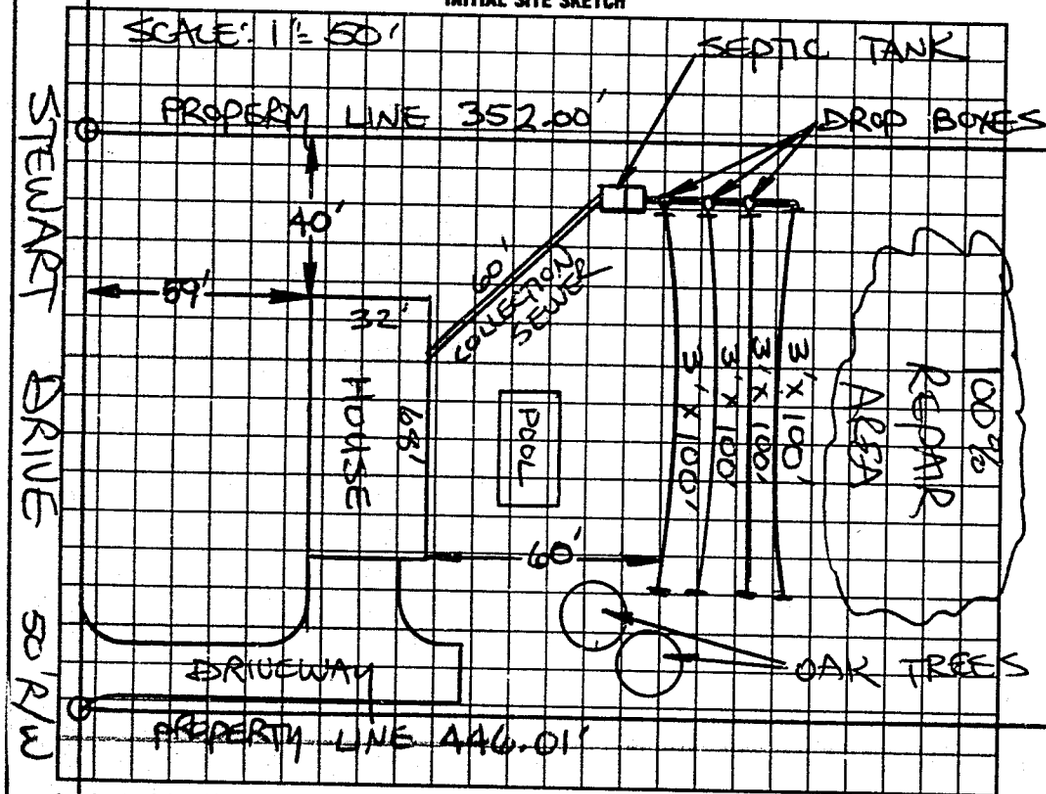

AS BUILT SKETCH

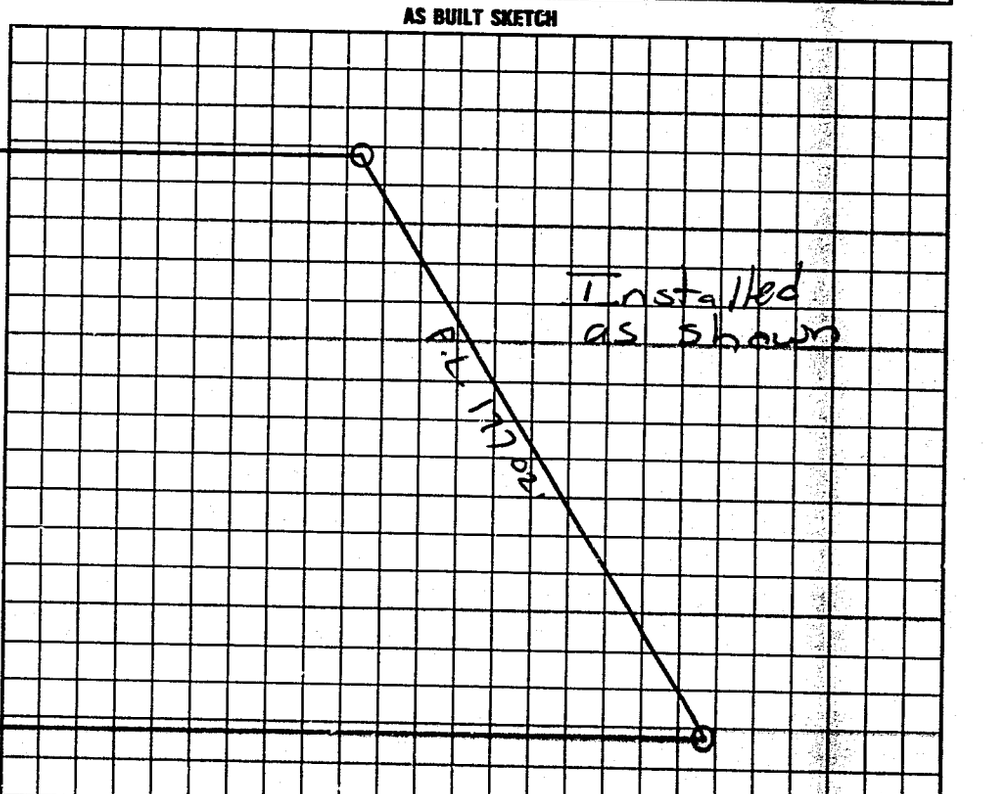

I understand that this permit can be suspended or revoked if any false information is supplied toward securing the permit/any unauthorized changes are made to the site/any unauthorized changes are made in the installation of the system. Improvement Permit is valid for 60 months from date of issuance. AUTHORIZATION TO CONSTRUCT IS VALID FOR 60 MONTHS FROM DATE OF ISSUANCE.

Signed: Norman Benfield

Improvement Permit by: STEVE HEDRICK date 10-29-97

AUTH. TO CONST.

~~Existing System Inspection~~ by: STEVE HEDRICK date 10-29-97

Installed by: Maiden Septic Tank Servis

~~Certificate of Completion by:~~ date

Operation Permit by: Mat COX for RS date 8-12-98

HEALTH DEPT. COPY: WHITE INSPECTION COPY (FINAL): GREEN OWNER COPY (FINAL): YELLOW INSPECTION COPY (INITIAL): PINK OWNER COPY (INITIAL): GOLD