46111

IREDELL COUNTY HEALTH DEPARTMENT

STATESVILLE 704-878-5305 MOORESVILLE 704-664-5281

IMPROVEMENT PERMIT / CERTIFICATE OF COMPLETION / OPERATION PERMIT / EXISTING SYSTEM INSPECTION

PROPERTY DESCRIPTION NO. 15639 DATE 6-11-93 TAX MAP NO. 8N-2-A-12

OWNER OR CONTRACTOR James L. Foster PHONE: Business _____ Home _____

ADDRESS _____

LOCATION I40W TL Old Mtn Rd. TR Beulah Rd. Stay Straight Mackmill Rd. TR Stewart Dr. Lot on R

SUBDIVISION Stewart Acres BLOCK / SECTION _____ LOT 12 LOT AREA 1 acre SITE CLASS. PS. L.T.A.R. .35 gpd / ft²

Water Supply: ☑ Individual ☐ Community ☐ Public Well

Septic Tank: 1500 Gallons; STB 797 Date —

Pump Tank: — Gallons; PT — Date —

Nitrification Field: No Fields 1 Square Feet 1035 Linear Feet 345'

No Lines 3 Trench Width 36" Trench Depth 36" Gravel Depth 12"

☑ New System ☐ Repair System Type: I, II, IV, V, VI

System Description: conventional, gravity

Repair System Description: " "

Maintenance Agreement Required: ☐ Yes ☑ No

☑ House/Mod. Home No. Bedrooms 3 Garbage Disposal: ☑ Yes ☐ No

☐ Mobile Home No. Bathrooms 2 Auto. Dishwasher: ☑ Yes ☐ No


☐ Business No. Employees _____ Auto. Washing Machine: ☑ Yes ☐ No

☐ Other _____ Other _____


☐ Slab ☑ Crawl Space ☐ Basement w/plumbing ☐ Basement wo/plumbing

Comments 100% Repair below system, conventional, gravity fed.

INITIAL SITE SKETCH

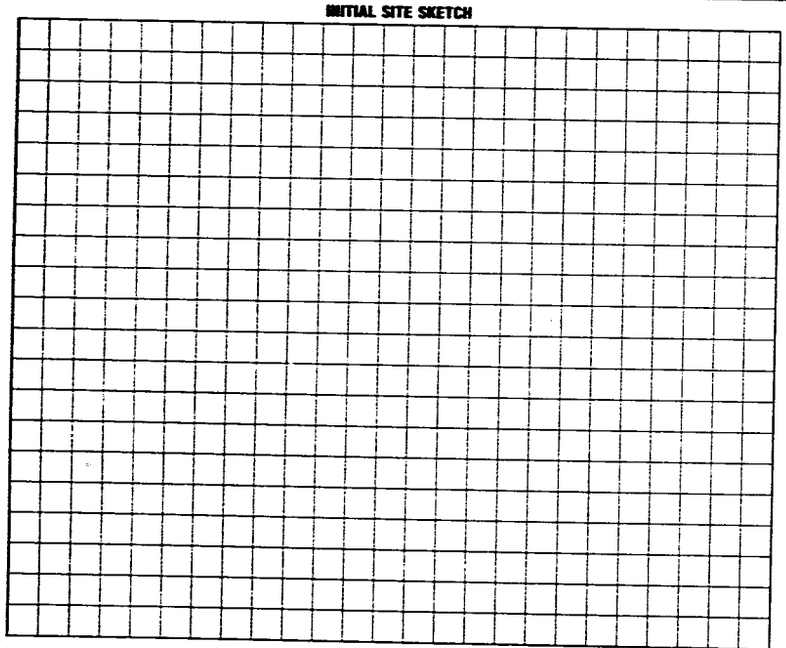

AS BUILT SKETCH

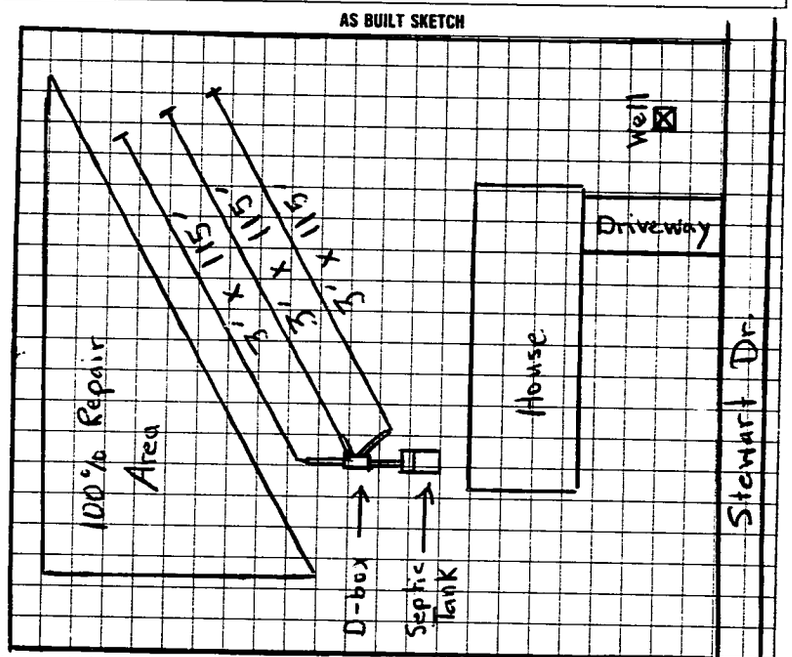

I understand that this permit can be suspended or revoked if any false information is supplied toward securing the permit/any unauthorized changes are made to the site/any unauthorized changes are made in the installation of the system. Improvement Permit is valid for 60 months from date of issuance.

Signed: _____

Improvement Permit by: Steve Hedrick date 6-13-93

Existing System Inspection by: _____ date _____

Installed by: Wes Lytton

Certificate of Completion by: Michael J. Dennis date 6-11-93

Operation Permit by: _____ date _____

HEALTH DEPT. COPY: WHITE INSPECTION COPY (FINAL): GREEN OWNER COPY (FINAL): YELLOW INSPECTION COPY (INITIAL): PINK OWNER COPY (INITIAL): GOLD