IREDELL COUNTY HEALTH DEPARTMENT

STATESVILLE 704-878-5305 MOORESVILLE 704-664-5281

IMPROVEMENT PERMIT / AUTHORIZATION TO CONSTRUCT / OPERATION PERMIT / EXISTING SYSTEM INSPECTION

PERMIT# 091890 PIN# 3793 97 9144 DATE 9-21-00

OWNER OR CONTRACTOR RHONDA BROWN PHONE: Business _____ Home 873-5496

ADDRESS 123 STEWART DR, STATESVILLE, NC 28677

LOCATION I-90 W, TL O.M.R., TR BULAH, CONTINUE MOCK MILL RD, TR STEWART DR, 2ND LOT ON LEFT

SUBDIVISION STEWART ACRES BLOCK / SECTION _____ LOT 24 LOT AREA 0.9391 ACRE SITE CLASS PS DESIGN FLOW 600 L.T.A.R. 0.35 GPD/FT²

Septic Tank: 1000 Gallons; STB 1007 Date 8-7-00
Pump Tank: _____ Gallons; PT _____ Date _____
Pump Make: _____ Model _____ Serial No. _____
Nitrification Field: No Fields 1 Square Feet 690 Linear Feet 170+/-
No Lines TWO Trench Width 36" Max Trench Bottom Depth 36" Depth SAND 6"

☑ New System ☐ Repair System Type: I. II (III) IV. V. VI
System Description: 25% REDUCTION GRAVITY
Repair System Description: 50% REDUCTION, PUMP
Maintenance Agreement Required: ☐ Yes ☑ No


☑ House/Mod. Home No. Bedrooms 4
☐ Mobile Home No. Bathrooms ____
☐ Business No. Employees ____
☑ Other W/ ONE OFFICE
☐ Slab ☑ Crawl Space ☐ Basement w/plumbing ☐ Basement wo/plumbing

Water Supply: ☑ Individual ☐ Public ☐ Community
WELL

Comments/Conditions: ① ADD SEPTIC TANK TO SYSTEM AS SHOWN ② REPLACE DIST. BOX WITH SERIES OF DROP BOXES (4) ③ INSTALL 28 CHAMBERS IN TWO LINES AS FLAGGED ON SITE

Comments/Conditions: ① NEW SANITARY TEE INSTALLED IN EXISTING SEPTIC TANK ② SEPTIC TANK WITH RISERS INSTALLED USING "POLYLOK" FILTER

INITIAL SITE SKETCH SCALE: 1" = 50'

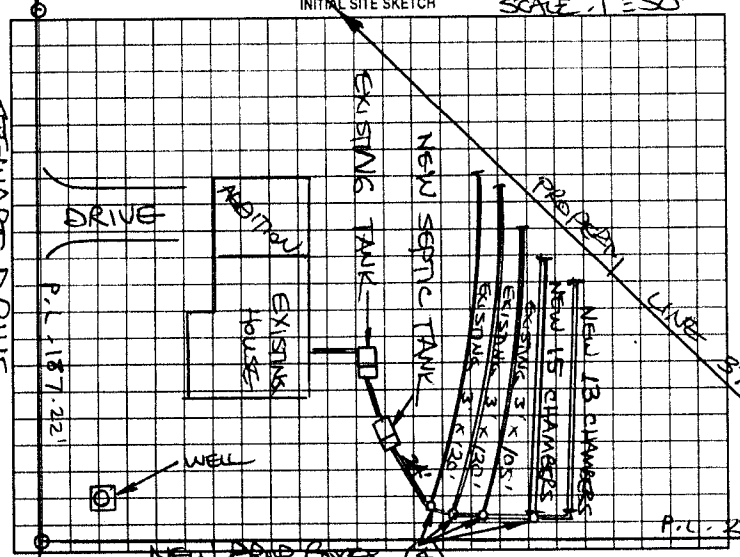

AS BUILT SKETCH

SYSTEM INSTALLED ACCORDING TO INITIAL SITE SKETCH

Permit can be suspended or revoked if any false information is supplied toward securing the permit/any unauthorized changes are made to the site/any unauthorized changes are made in the installation of the system. Improvement Permit with plat valid without expiration. Improvement Permit with site plan valid for sixty months. Authorization to Construct is valid for a period equal to that of Improvement Permit – not to exceed sixty months.

Signed: Jim Worthy date 9-21-00 Installed by: JODY TRAVIS

Improvement Permit by: STEVE HEDRICK date 9-21-00 Operation Permit by: STEVE HEDRICK date 9-27-00

Authorization to Construct by: STEVE HEDRICK date 9-21-00 Existing System Inspection by: _____ date _____

HEALTH DEPT COPY: WHITE OWNER COPY (FINAL): YELLOW OWNER COPY (INITIAL): PINK