41285

IREDELL COUNTY HEALTH DEPARTMENT

STATESVILLE 704-878-5305 MOORESVILLE 704-664-5281

IMPROVEMENT PERMIT / CERTIFICATE OF COMPLETION / OPERATION PERMIT / EXISTING SYSTEM INSPECTION

PROPERTY DESCRIPTION NO. 16324 DATE 9-7-93 TAX MAP NO. 8M-2-A-211

OWNER OR CONTRACTOR Jim Wooten (Rhonda Mohler) PHONE: Business _____ Home 873-1990

ADDRESS _____

LOCATION I-40W TL Old Mtn. Rd. TR Beulah Rd. stay straight Mock Mill Rd. TR Stewart Acres (Stewart Dr.) 1st Lot on L

SUBDIVISION Stewart Acres BLOCK / SECTION _____ LOT - LOT AREA .99acre SITE CLASS. P.S. L.T.A.R. .35gpd/ft²

Water Supply: ☑ Individual ☐ Community ☐ Public Well

Septic Tank: 1000 Gallons; ~~GTB~~ 6-19-93 ~~Date~~ 1012

Pump Tank: — Gallons; PT — Date —

Nitrification Field: No Fields 1 Square Feet 1035 Linear Feet 345'

No Lines 3 Trench Width 36" Trench Depth 18-24" Gravel Depth 12"

☑ New System ☐ Repair System Type: I (II) III. IV. V. VI

System Description: Conventional, gravity

Repair System Description: " "

Maintenance Agreement Required: ☐ Yes ☑ No

☑ House/Mod. Home No. Bedrooms 3 Garbage Disposal: ☐ Yes ☑ No

☐ Mobile Home No. Bathrooms 2 Auto. Dishwasher: ☑ Yes ☐ No


☐ Business No. Employees — Auto. Washing Machine: ☑ Yes ☐ No

☐ Other _____ Other _____


☑ Slab ☑ Crawl Space ☐ Basement w/plumbing ☐ Basement wo/plumbing

Comments 100% Repair Area below system, conventional, gravity fed.

INITIAL SITE SKETCH

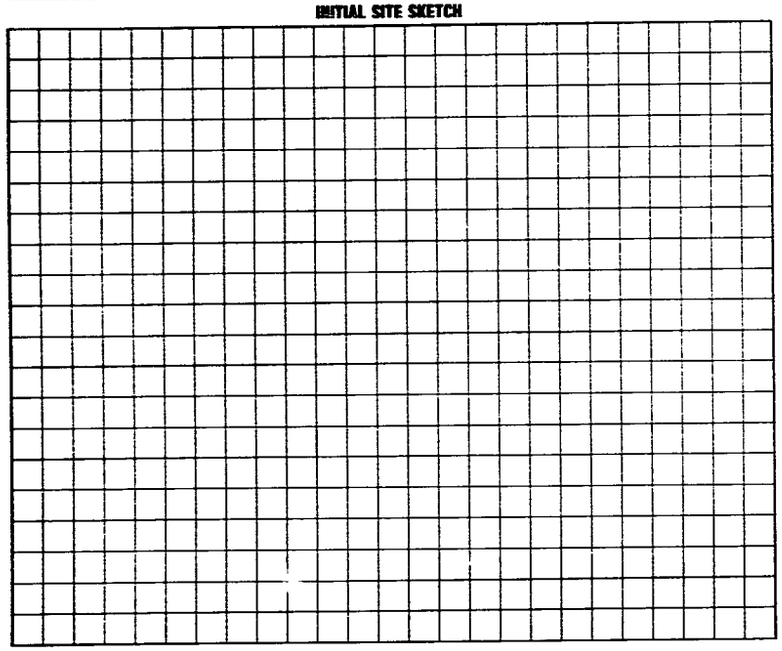

AS BUILT SKETCH

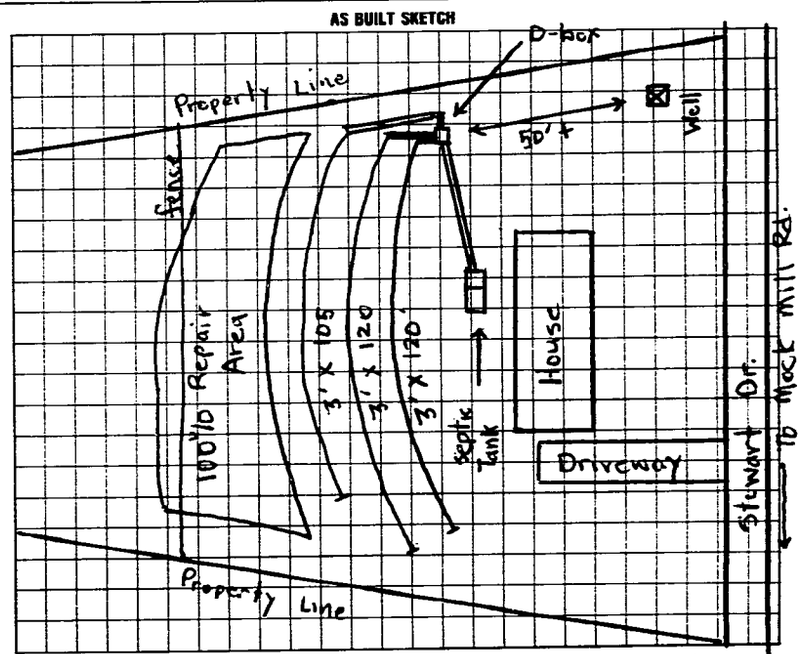

I understand that this permit can be suspended or revoked if any false information is supplied toward securing the permit/any unauthorized changes are made to the site/any unauthorized changes are made in the installation of the system. Improvement Permit is valid for 60 months from date of issuance.

Signed: _____

Improvement Permit by: Michael J. Dennis date 5-13-93

Existing System Inspection by: _____ date _____

Installed by: James Hydler

Certificate of Completion by: Michael J. Dennis date 9-7-93

Operation Permit by: _____ date _____

HEALTH DEPT. COPY: WHITE INSPECTION COPY (FINAL): GREEN OWNER COPY (FINAL): YELLOW INSPECTION COPY (INITIAL): PINK OWNER COPY (INITIAL): GOLD