This permit voids previously issued permit dated 9/11/03.

IREDELL COUNTY HEALTH DEPARTMENT

STATESVILLE 704-878-5305 (CI) MOORESVILLE 704-664-5281

IMPROVEMENT PERMIT / AUTHORIZATION TO CONSTRUCT / OPERATION PERMIT / EXISTING SYSTEM INSPECTION

PERMIT# 114697 PIN# 3794-00-8474 DATE 2/17/04

OWNER OR CONTRACTOR David Massey PHONE: Business — Home (704) 924-8348

ADDRESS 240 St Jill Circle Statesville N.C. 28677

LOCATION I-40 W, (R) Sharon School Rd (L) Island Ford Rd, 1st drive to (L) past Carroll Drive (off Road)

SUBDIVISION — BLOCK / SECTION — LOT — LOT AREA 15.03 Acres SITE CLASS. PS DESIGN FLOW 360 L.T.A.R. .25 gpd/ft2

Septic Tank: 4000 Gallons; STB 794 Date 1-12-04
Pump Tank: Gallons; PT Date
Pump Make: Model Serial No.
Nitrification Field: No Fields 1 Square Feet 1440 Linear Feet 480
No Lines 4 @ 120' Trench Width 36" Max Trench Bottom Depth 30" Gravel Depth 12"

☒ New System ☐ Repair System Type: I, II, III, IV, V, VI
System Description: Gravity, Conventional
Repair System Description: Gravity, Conventional
Maintenance Agreement Required: ☐ Yes ☐ No

☒ House/Mod. Home ☐ Mobile Home ☐ Business ☐ Other
No. Bedrooms 3 No. Bathrooms 2 No. Employees


☐ Slab ☒ Crawl Space ☐ Basement w/plumbing ☐ Basement wo/plumbing

Water Supply: ☒ Individual ☐ Public ☐ Community


Comments:/Conditions: (1) Install lines on Contour (2) do not install when wet (3) Keep well 100 ft from septic system.

Comments:/Conditions: Lines Okay - 7/23/04
- Zabel Filter + ST marker Installed

INITIAL SITE SKETCH

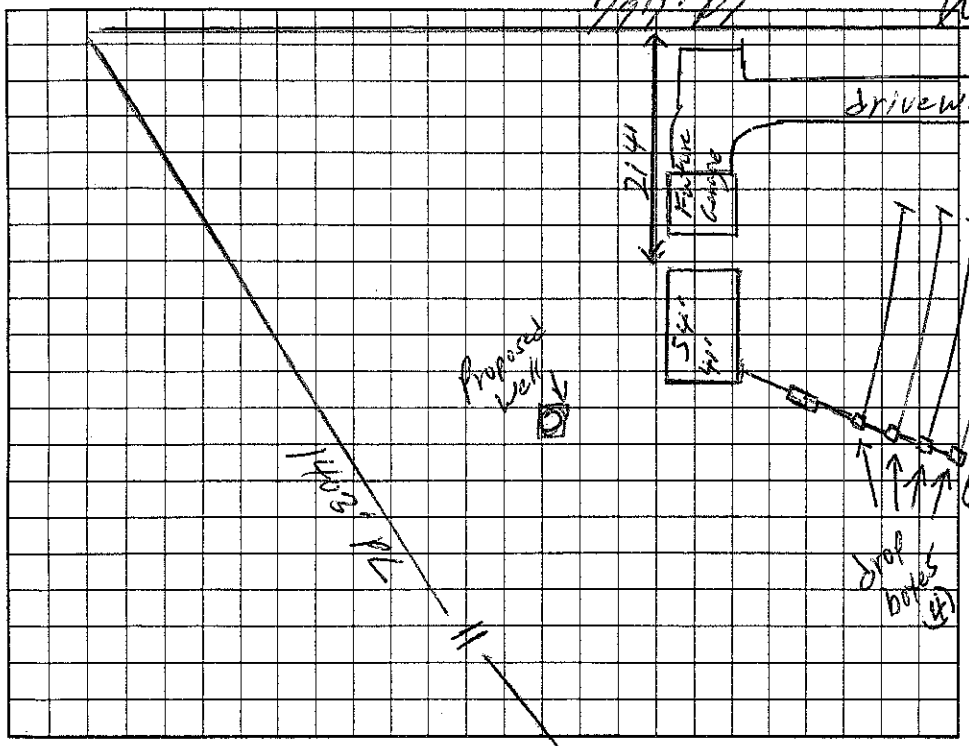

AS BUILT SKETCH

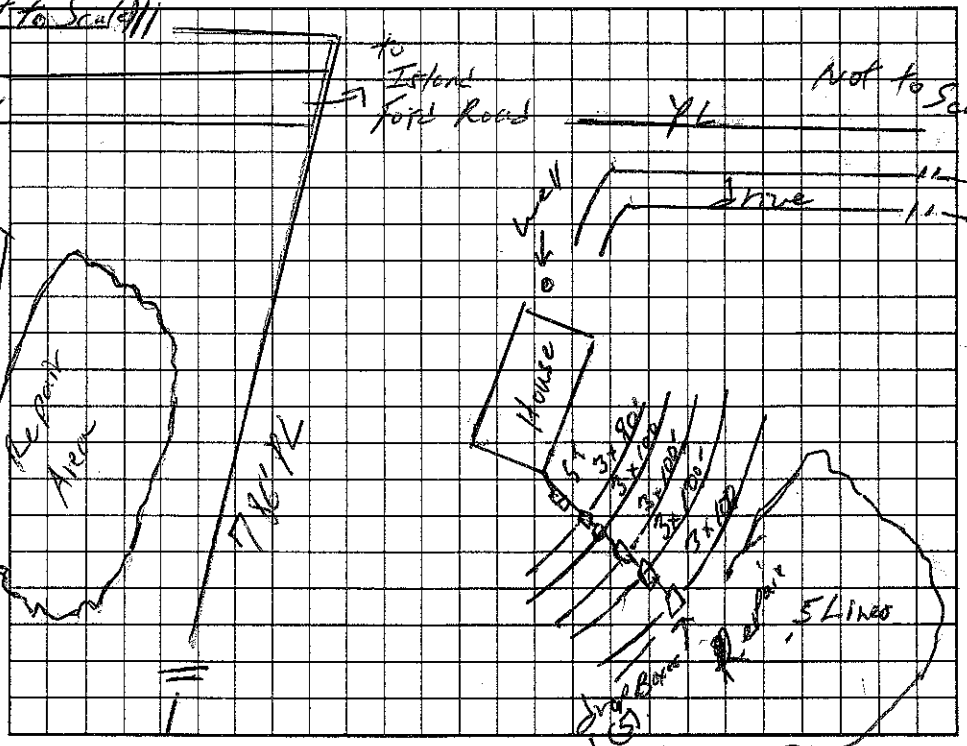

Permit can be suspended or revoked if any false information is supplied toward securing the permit/any unauthorized changes are made to the site/any unauthorized changes are made in the installation of the system. Improvement Permit with plat valid without expiration. Improvement Permit with site plan valid for sixty months. Authorization to Construct is valid for a period equal to that of Improvement Permit -- not to exceed sixty months.

Signed: David S Massey date

Installed by: Bob's Backhoe Service

Improvement Permit by: William O Johnson date 2/17/04

Operation Permit by: William O Johnson date 7/23/04

Authorization to Construct by: William O. Johnson date 2/17/04

Existing System Inspection by: date

HEALTH DEPT. COPY: WHITE OWNER COPY (FINAL): YELLOW OWNER COPY (INITIAL): PINK