IREDELL COUNTY HEALTH DEPARTMENT

STATESVILLE 704-878-5305 (C1) MOORESVILLE 704-664-5281

IMPROVEMENT PERMIT / AUTHORIZATION TO CONSTRUCT / OPERATION PERMIT / EXISTING SYSTEM INSPECTION

(C1)

PERMIT# 135859 PIN# 3794-01-5351 4199 DATE 6-02-2006

OWNER OR APPLICANT HUEY D. & TERRELL F. MOORE PHONE: Business 704-880-0048 Home 704-873-0789

ADDRESS 135 CORRAL CIRCLE, STATESVILLE NC 28677

LOCATION ISLAND FORD ROAD TO CORRAL CIRCLE BEAR RIGHT TO HOUSE SITE,

SUBDIVISION _____ BLOCK / SECTION _____ LOT _____ LOT AREA 12.11 ACRES/PT 4.37 ACRES SITE CLASS. PS DESIGN FLOW 360 L.T.A.R. 0.20 GPD/FT²

Septic Tank: EXISTING Gallons: STB _____ Date _____

Pump Tank: _____ Gallons: PT _____ Date _____

Pump Make: _____ Model _____ Serial No. _____

Nitrification Field: No Fields 1 Square Feet 600 Linear Feet 200

No Lines 2 Trench Width 36" Max Trench Bottom Depth 36" Gravel Depth 12"

☐ New System ☐ Repair ☑ Expansion System Type: I II III IV V VI

System Description: CONVENTIONAL GRAVITY

Repair System Description: CONVENTIONAL GRAVITY

Maintenance Agreement Required: ☐ Yes ☑ No

☑ Gravity ☐ Pressure ☐ Slab ☑ Crawl Space ☐ Basement w/plumbing ☐ Basement wo/plumbing

☑ House/Mod. Home No. Bedrooms 3

☐ Mobile Home No. Persons _____

☐ Business No. Employees _____

☐ Other _____


Water Supply: ☑ Individual ☐ Public ☐ Community WELL

Comments:/Conditions: AN "ACCEPTED" SYSTEM MAY ALSO BE USED.

Comments:/Conditions:

INITIAL SITE SKETCH

SCALE: 1"=50'

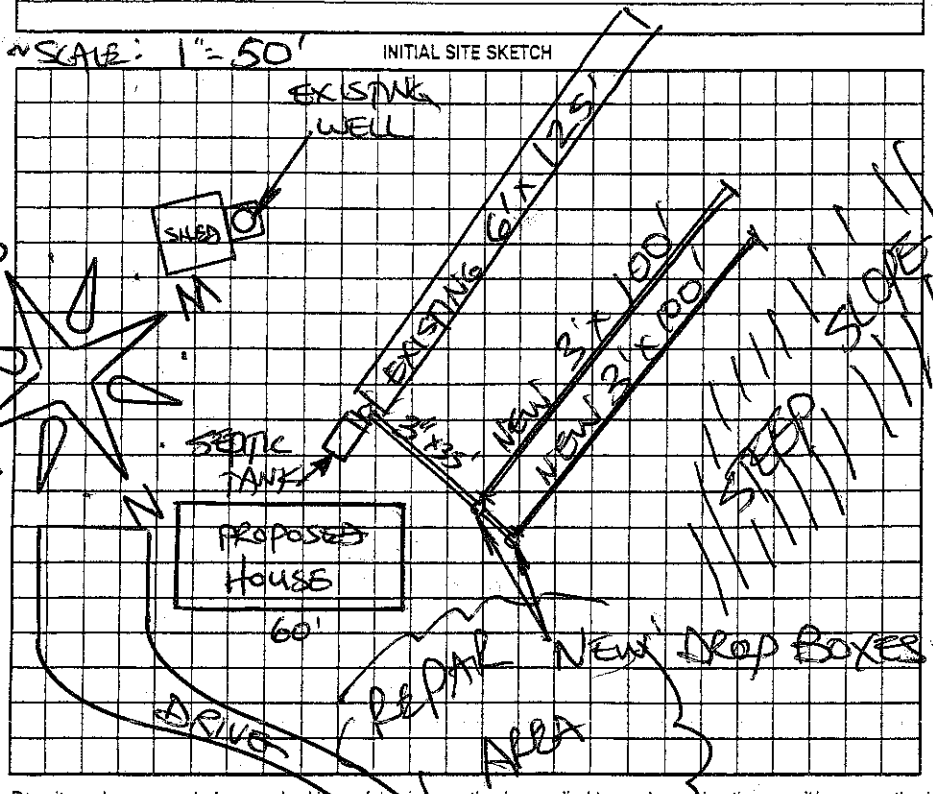

AS BUILT SKETCH

SYSTEM EXPANDED AS SHOWN USING "QUICK-4 INFILTRATOR" CHAMBERS AS AN "ACCEPTED" SYSTEM

Permit can be suspended or revoked if any false information is supplied toward securing the permit/any unauthorized changes are made to the site/any unauthorized changes are made in the installation of the system. Improvement Permit with plat valid without expiration ☐ Improvement Permit with site plan valid for sixty months ☑ Authorization to Construct is valid for a period equal to that of Improvement Permit – not to exceed sixty months.

Signed: Terrell F. Moore date 6-2-06 Installed by: BOB'S BACKHOE

Improvement Permit by: STEVE HEDRICK date 6-2-06 Operation Permit by: STEVE HEDRICK date 9-8-06

Authorization to Construct by: STEVE HEDRICK date 6-2-06 Existing System Inspection by: _____ date _____

HEALTH DEPT. COPY: WHITE OWNER COPY (FINAL): YELLOW OWNER COPY (INITIAL): PINK