IREDELL COUNTY HEALTH DEPARTMENT

STATESVILLE 704-878-5305 MOORESVILLE 704-664-5281

IMPROVEMENT PERMIT / AUTHORIZATION TO CONSTRUCT / OPERATION PERMIT / EXISTING SYSTEM INSPECTION

PERMIT # 15584 PIN # 3794-01-7957 DATE 9 July 09

OWNER or APPLICANT Steve & Teresa Shook PHONE: Business (704) 682-0387 Home: (704) 873-5809

OWNER or APPLICANT ADDRESS 2022 Island Ford Rd. Statesville, N.C.

LOCATION / DIRECTIONS Hwy 90 W TR Old Mtn. Road TL ISLAND FORD Rd. Cross 2nd Bridge - 2nd drive on Rt.

SUBDIVISION BLOCK / SECTION LOT # 2 LOT AREA DESIGN FLOW 240 g.p.d. L.T.A.R.

Septic Tank Existing Gallons: STB Date

Pump Tank Gallons: P T Date

Pump Make Model Serial #

Nitrification Field No Fields No Lines Linear Feet

Trench Width Max. Trench Bottom Depth Gravel Depth

☐ New System ☐ Repair ☐ Expansion System Type I (II) III IV V VI

System Description:

Repair System Description:

Maintenance Agreement Required ☐ YES ☐ NO

☐ GRAVITY ☐ PRESSURE

☑ Residence No. Bedrooms 3

☐ Business No. Persons

☐ Other No. Employees

☐ Slab ☐ Crawl Space

☐ Basement w/plumbing ☐ Basement w/o plumbing

Water Supply

☑ Private

☐ Public


☐ Community

Comments / Conditions

Comments / Conditions * Existing system not failing to the surface at this time - New addition to existing house. No increase in bedrooms.

INITIAL SITE SKETCH

AS BUILT SKETCH

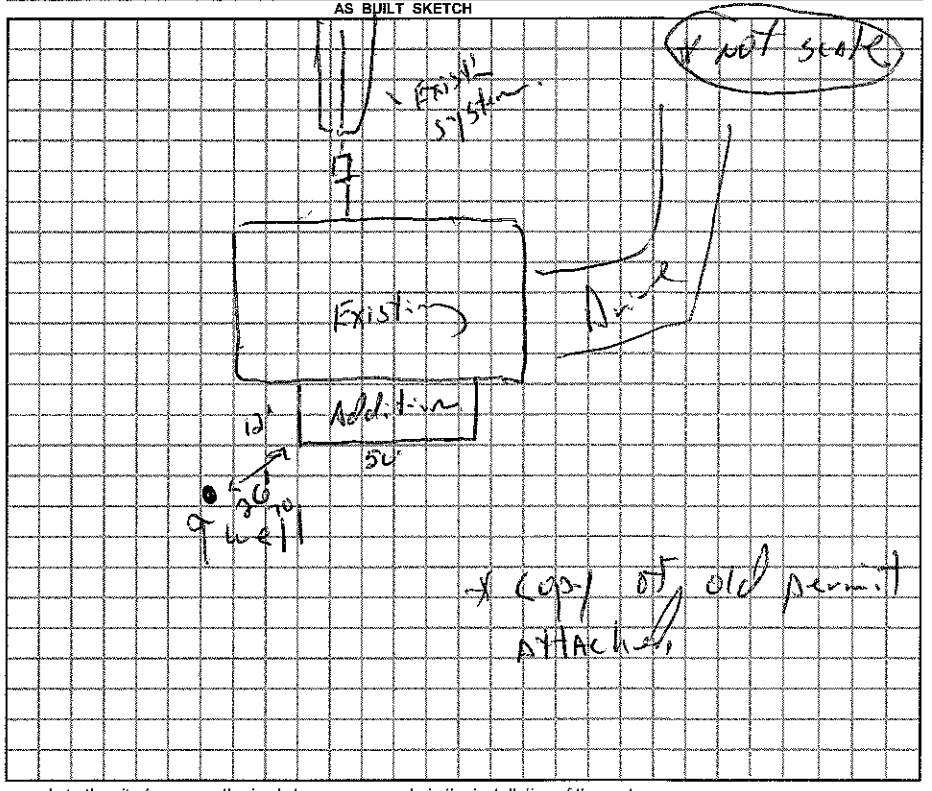

Permit can be suspended or revoked if any false information is supplied toward securing the permit / any unauthorized changes are made to the site / any unauthorized changes are made in the installation of the system.

☐ *IMPROVEMENT PERMIT w / plat valid without expiration.* ☐ *IMPROVEMENT PERMIT w / site plan valid for 60 mos.* ☐ *AUTHORIZATION TO CONSTRUCT valid for period equal to IMPROVEMENT PERMIT-not to exceed 60 mo.*

Owner / Applicant Signature: Teresa D. Shook Date 7-21-09

Improvement Permit by: Date

Authorization to Construct by: Date

YOU SHOULD CONTACT A LOCATOR SERVICE PRIOR TO ANY EXCAVATION.

Installed by:

Operation Permit by: Date:

Existing System Inspected by: R-S Date: 9 July 09

WHITE COPY Environmental Health YELLOW COPY (final) Owner / Applicant PINK COPY (Initial) Owner / Applicant