IREDELL COUNTY HEALTH DEPARTMENT

Statesville Phone TR 3-7271 Mooresville Phone NO 3-1271

PERMIT TO INSTALL SEPTIC TANK

Permit No. 216 Permit Date 3-2 1973

Owner Robert N. Warren Address 725 Hartness Rd. Statesville

Installed By Parker Lackey Const. Co. Address Rt. 1 Stony Point N.C.


Location of Property At Barn on Island Ford Rd - about 2 ½ mi past Bradford X Rds. on Left.

Tank		Capacity		Length of Lines		Fixtures	
Block	( )	1000	(✓)	225'	(✓)	No. of Baths	(1)
Precast	(✓)	1250	( )	250'	( )	Dishwasher	( )
		1500	( )	Other		Garbage Grdr.	( )
		Other				Other	

NOTIFY HEALTH DEPARTMENT AT LEAST EIGHT HOURS BEFORE TANK IS TO BE INSPECTED.

Final Inspection 19 Approved ( ) Disapproved ( )

Remarks well over Howard ft from Lines

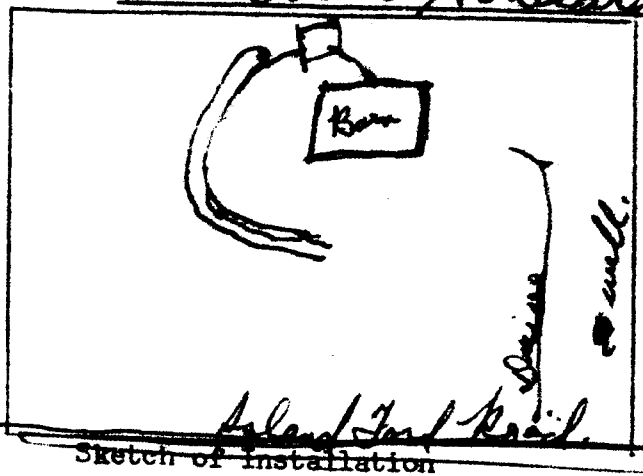

Sketch of Installation

Sanitarian