This permit voids previously issued permit dated 12/31/01.

IREDELL COUNTY HEALTH DEPARTMENT

STATESVILLE 704-878-5305 ✓ MOORESVILLE 704-664-5281

IMPROVEMENT PERMIT / AUTHORIZATION TO CONSTRUCT / OPERATION PERMIT / EXISTING SYSTEM INSPECTION

PERMIT# 103683 PIN# 3794-01-9857 DATE 4/15/02

OWNER OR CONTRACTOR Kevin Sharpe PHONE: Business — Home (704) 873-5809

ADDRESS 132 Jo Mar Loop Statesville, N.C. 28625

LOCATION I-40 West, (B) Old Mtn Road, (C) on Island Ford, go past 2nd Bridge 1st Brick on Right

SUBDIVISION — BLOCK / SECTION — LOT 3 LOT AREA 3.33 SITE CLASS PS DESIGN FLOW 480 L.T.A.R. .30

Septic Tank: 4,000 Gallons: STB 760 Date 11-3-01

Pump Tank: — Gallons: PT — Date —

Pump Make: — Model — Serial No —

Nitrification Field: No Fields 1 Square Feet equiv to 1600 Linear Feet 400

No Lines 6 Trench Width 36" Max Trench Bottom Depth 36" Gravel Depth —

X New System ☐ Repair System Type: I II III IV V VI

System Description: Gravity Conventional

Repair System Description: Pump, 25% Red.

Maintenance Agreement Required: ☐ Yes X No

X House/Mod. Home No. Bedrooms 4

☐ Mobile Home No. Bathrooms 3

☐ Business No. Employees —

☐ Other —


☐ Slab ☐ Crawl Space ☐ Basement w/plumbing X Basement wo/plumbing

Water Supply: X Individual ☐ Public ☐ Community


Comments/Conditions: ① Install lines on Contour ② Install 25% Reduction System of Chamberr or HOES. ③ Install Flow divider tee ④ Maintain proper set backs (24' From House to Start of First line)

Comments/Conditions — Septic Tank Marker Installed — Label Filter Installed — Infiltrator Chambers Installed (6)

INITIAL SITE SKETCH (Not to Scale)

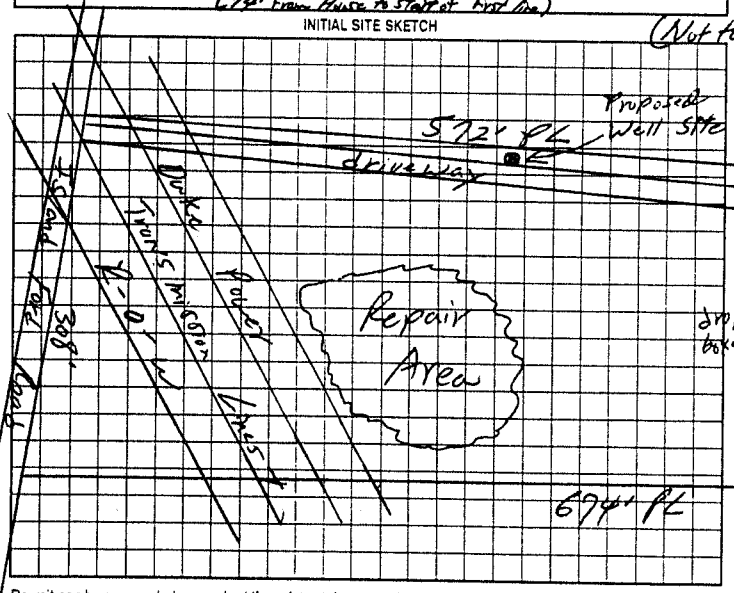

AS BUILT SKETCH

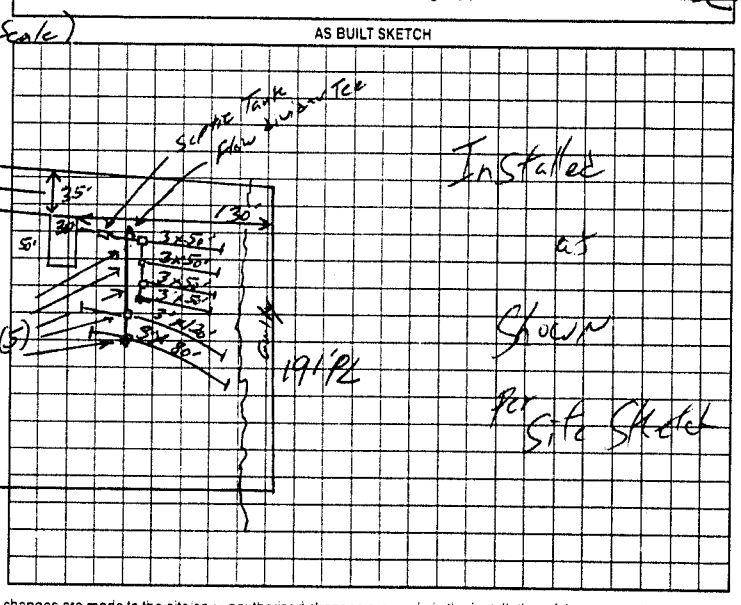

Permit can be suspended or revoked if any false information is supplied toward securing the permit/any unauthorized changes are made to the site any unauthorized changes are made in the installation of the system. Improvement Permit with plat valid without expiration. Improvement Permit with site plan valid for sixty months. Authorization to Construct is valid for a period equal to that of Improvement Permit - not to exceed sixty months

Signed: Talbert R Pahan date —

Improvement Permit by: William O. Johnson date 4/15/02

Authorization to Construct by: William O. Johnson date 4/15/02

Installed by Brian McDaniel

Operation Permit by William O. Johnson date 4/18/02

Existing System Inspection by: — date —

HEALTH DEPT. COPY: WHITE OWNER COPY (FINAL): YELLOW OWNER COPY (INITIAL): PINK