IREDELL COUNTY HEALTH DEPARTMENT

STATESVILLE 704-878-5305 CT MOORESVILLE 704-664-5281

IMPROVEMENT PERMIT / AUTHORIZATION TO CONSTRUCT / OPERATION PERMIT / EXISTING SYSTEM INSPECTION

PERMIT# 101351 PIN# 3794-16-2582.A DATE 8/15/01

OWNER OR CONTRACTOR Glenda Hall PHONE. Business — Home (704) 786-9652

ADDRESS 6300 Rocky River Rd. Concord, N.C. 28025

LOCATION I-40 W, (R) Old Mtn Rd, (L) New Sterling Church Rd (R) (L) Cotton Gin Rd 4th R to 2nd pines in middle of Forest

SUBDIVISION — BLOCK / SECTION — LOT — LOT AREA ~15.0 Ac SITE CLASS PS DESIGN FLOW 360 L.T.A.R. .3

Septic Tank: 1000 Gallons: STB 312 Date 8-6-01
Pump Tank: ____ Gallons; PT ____ Date ____
Pump Make: ____ Model ____ Serial No. ____
Nitrification Field: No. Fields 1 Square Feet 1200 Linear Feet 400
No. Lines 4 Trench Width 36" Max Trench Bottom Depth 30" Gravel Depth 12"

[X] New System [ ] Repair System Type: (I) III. IV. V. VI
System Description: Gravity, Conventional
Repair System Description: Gravity, Conventional
Maintenance Agreement Required: [ ] Yes [X] No

[X] House/Mod. Home No. Bedrooms 3
[ ] Mobile Home No. Bathrooms 2
[ ] Business No. Employees ____
[ ] Other ____


[ ] Slab [X] Crawl Space [ ] Basement w/plumbing [ ] Basement wo/plumbing

Water Supply: [X] Individual [ ] Public [ ] Community


Comments/Conditions: (1) Keep well 100 ft From Septic System (2) Install 12" on contour Cotton Gin Rd ~1250' PL

Comments/Conditions (3) Call Health Dept for layout of System after clearing if needed. - ST. marker + Zabel Fitting installed

INITIAL SITE SKETCH Scale 1" = 60'

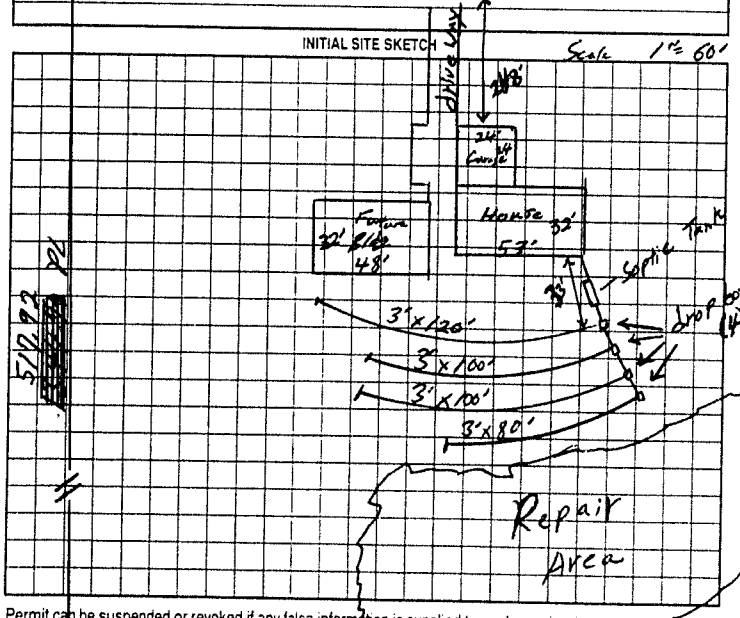

AS BUILT SKETCH Not to Scale

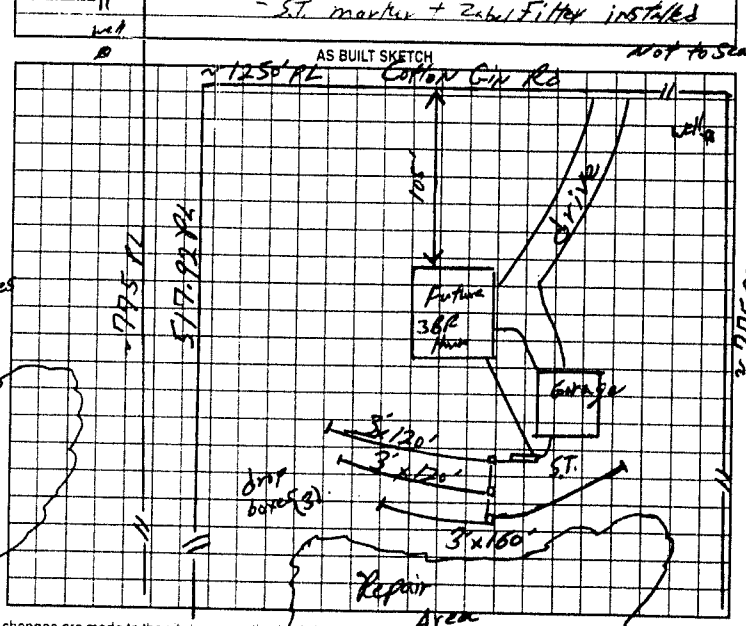

Permit can be suspended or revoked if any false information is supplied toward securing the permit/any unauthorized changes are made to the site/any unauthorized changes are made in the installation of the system. Improvement Permit with plat valid without expiration. Improvement Permit with site plan valid for sixty months. Authorization to Construct is valid for a period equal to that of Improvement Permit – not to exceed sixty months.

Signed: R.C. McClelland date 8/17/01 Installed by: Marty Tucker

Improvement Permit by: William O. Johnson date 8/15/01 Operation Permit by: William O. Johnson date 7/25/02

Authorization to Construct by: William O. Johnson date 8/15/01 Existing System Inspection by: ____ date ____

HEALTH DEPT COPY WHITE OWNER COPY (FINAL) YELLOW OWNER COPY (INITIAL) PINK