IREDELL COUNTY HEALTH DEPARTMENT

STATESVILLE 704-878-5305 MOORESVILLE 704-664-5281

IMPROVEMENT PERMIT / CERTIFICATE OF COMPLETION / OPERATION PERMIT / EXISTING SYSTEM INSPECTION

PROPERTY DESCRIPTION NO. 16552 DATE 6-25-93 TAX MAP NO. 8P-A-16

OWNER OR CONTRACTOR Allen Brown PHONE: Business _____ Home _____

ADDRESS Rt. 9 Box A-409, Statesville, N.C. 28677

LOCATION I-40 W JR Old Mtn. Rd. TL Island Ford Rd. TR Cotton Gin Rd TL entrance MHP. 2nd last Lot on R.

SUBDIVISION Shady Fork MHP BLOCK / SECTION _____ LOT 8A LOT AREA _____ SITE CLASS. Existing L.T.A.R Existing

Water Supply: ☐ Individual ☐ Community ☑ Public

Septic Tank: Existing Gallons; STB _____ Date _____

Pump Tank: _____ Gallons; PT _____ Date _____

Nitrification Field: No Fields _____ Square Feet _____ Linear Feet _____

No Lines _____ Trench Width _____ Trench Depth _____ Gravel Depth _____

☐ New System ☐ Repair System Type: I, II, II, IV, V, VI

System Description: _____

Repair System Description: _____

Maintenance Agreement Required: ☐ Yes ☐ No

☐ House/Mod. Home ☑ Mobile Home ☐ Business ☐ Other _____

No. Bedrooms 2 No. Bathrooms 2 No. Employees 1

☐ Slab ☑ Crawl Space ☐ Basement w/plumbing ☐ Basement wo/plumbing

Garbage Disposal: ☐ Yes ☑ No

Auto. Dishwasher: ☐ Yes ☑ No


Auto. Washing Machine: ☑ Yes ☐ No

Other _____

Comments 2 MH's on one system. Pulled off 2 bedroom MH, moving on another 2 bedroom MH.

INITIAL SITE SKETCH

AS BUILT SKETCH

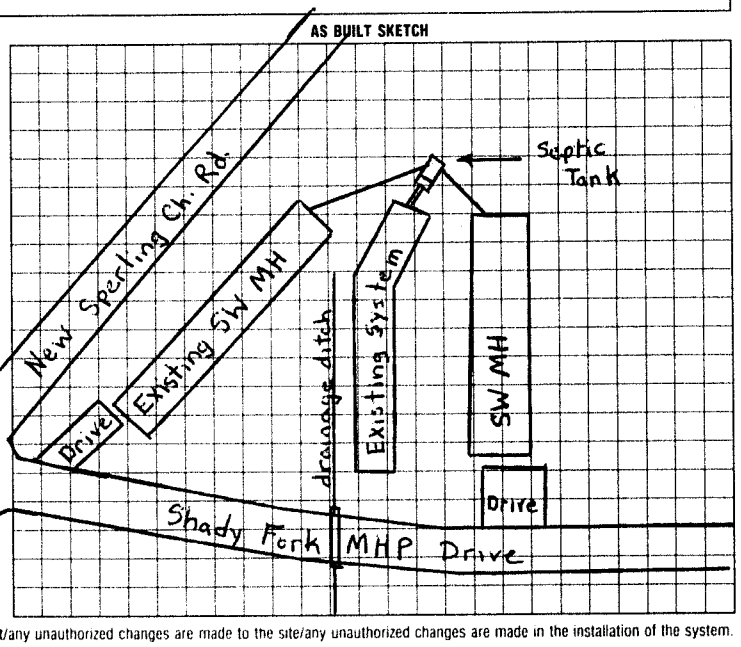

I understand that this permit can be suspended or revoked if any false information is supplied toward securing the permit/any unauthorized changes are made to the site/any unauthorized changes are made in the installation of the system. Improvement Permit is valid for 60 months from date of issuance.

Signed: _____ Installed by: _____

Improvement Permit by: _____ date _____ Certificate of Completion by: _____ date _____

Existing System Inspection by: Michael J. Dennis date 6-25-93 Operation Permit by _____ date _____

HEALTH DEPT. COPY WHITE INSPECTION COPY (FINAL) GREEN OWNER COPY (FINAL) YELLOW INSPECTION COPY (INITIAL) PINK OWNER COPY (INITIAL) GOLD