IREDELL COUNTY HEALTH DEPARTMENT

STATESVILLE 704-878-5305 MOORESVILLE 704-664-5281

IMPROVEMENT PERMIT / AUTHORIZATION TO CONSTRUCT / OPERATION PERMIT / EXISTING SYSTEM INSPECTION

PERMIT# 087826 PIN# 3794 17 5385 (PT) DATE 2-18-00

OWNER OR CONTRACTOR DENNY HALL PHONE: Business _____ Home 873-3754

ADDRESS 358 MILLER FARM ROAD, STATESVILLE, NC 28625

LOCATION I-40 W, TR OLD MTN. RD, TL NEW STERLING CH. RD, TL COTTON GIN RD, TR SHADY FORK

SUBDIVISION SHADY FORK MHP BLOCK / SECTION _____ LOT 9B LOT AREA MHP 7.98AC SITE CLASS PS DESIGN FLOW 240 L.T.A.R. EXISTING

Septic Tank: EXISTING Gallons; STB _____ Date _____

Pump Tank: _____ Gallons; PT _____ Date _____

Pump Make: _____ Model _____ Serial No. _____

Nitrification Field: No Fields L Square Feet _____ Linear Feet EXISTING

No Lines _____ Trench Width _____ Max Trench Bottom Depth _____

☐ New System ☐ Repair System Type: I II III IV V VI

System Description: CONVENTIONAL GRAVITY

Repair System Description: _____

Maintenance Agreement Required: ☐ Yes ☒ No

Gravel Depth EXISTING ☒ Slab ☐ Crawl Space ☐ Basement w/plumbing ☐ Basement wo/plumbing

☐ House/Mod. Home No. Bedrooms 2

☒ Mobile Home No. Bathrooms 2

☐ Business No. Employees ____

☐ Other _____


Water Supply: ☐ Individual ☐ Public ☒ Community

Comments:/Conditions:

Comments:/Conditions: SYSTEM UNDERSIZED BY TODAY'S STANDARDS

INITIAL SITE SKETCH

AS BUILT SKETCH

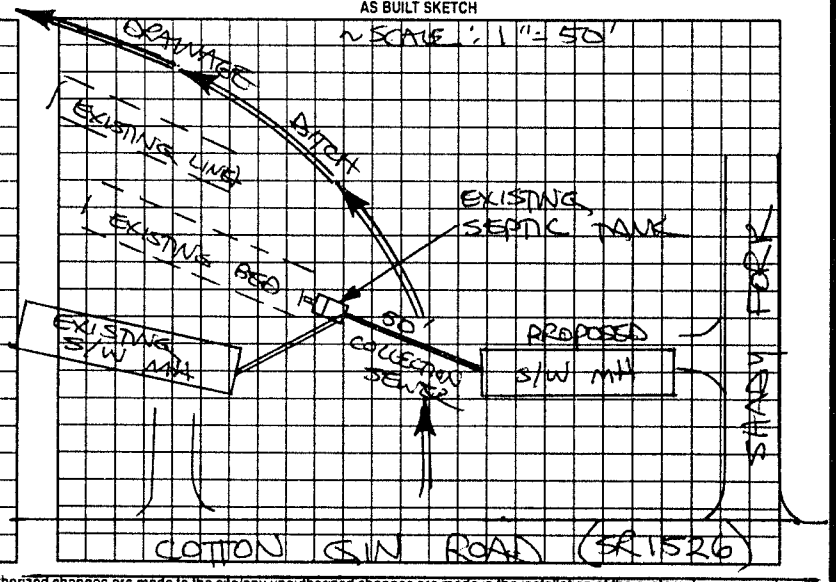

Permit can be suspended or revoked if any false information is supplied toward securing the permit/any unauthorized changes are made to the site/any unauthorized changes are made in the installation of the system. Improvement Permit with plat valid without expiration. Improvement Permit with site plan valid for sixty months. Authorization to Construct is valid for a period equal to that of Improvement Permit – not to exceed sixty months.

Signed: _____ date _____ Installed by: _____

Improvement Permit by: _____ date _____ Operation Permit by: _____ date _____

Authorization to Construct by: _____ date _____ Existing System Inspection by: STEVE HEDRICK date 2-18-00

HEALTH DEPT. COPY: WHITE OWNER COPY (FINAL): YELLOW OWNER COPY (INITIAL): PINK