IREDELL COUNTY HEALTH DEPARTMENT

STATESVILLE 704-878-5305 — Existing System MOORESVILLE 704-664-5281

IMPROVEMENT PERMIT / AUTHORIZATION TO CONSTRUCT / OPERATION PERMIT / EXISTING SYSTEM INSPECTION

PERMIT# 90050 PIN# 3794175385 DATE June 13 2000

OWNER OR CONTRACTOR Tiffany Jones / David Millsaps PHONE: Business _____ Home 873 1531 D Millsaps

ADDRESS _____

LOCATION _____

SUBDIVISION Shady Rest MHP BLOCK / SECTION _____ LOT 1A LOT AREA _____ SITE CLASS. _____ DESIGN FLOW _____ L.T.A.R. _____ OK by JCP 6/14/00

Septic Tank: Existing Gallons: STB _____ Date _____
Pump Tank: _____ Gallons: PT _____ Date _____
Pump Make: _____ Model _____ Serial No. _____
Nitrification Field: No Fields ____ Square Feet _____ Linear Feet _____
No Lines 3 Trench Width _____ Max Trench Bottom Depth _____ Gravel Depth _____

☐ New System ☐ Repair System Type: I. II. III. IV. V. VI
System Description: _____
Repair System Description: _____
Maintenance Agreement Required: ☐ Yes ☒ No


☐ House/Mod. Home No. Bedrooms 3
☒ Mobile Home SW No. Bathrooms 2
☐ Business No. Employees ____
☐ Other _____
☐ Slab ☒ Crawl Space ☐ Basement w/plumbing ☐ Basement wo/plumbing

Water Supply:
☒ Individual
☐ Public
☐ Community


Comments:/Conditions: No Sign of Failure AT This Time

Comments:/Conditions:

INITIAL SITE SKETCH

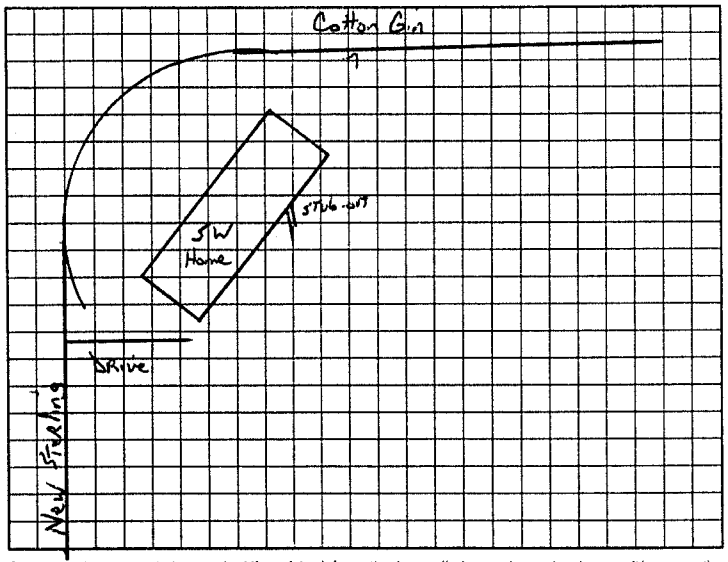

AS BUILT SKETCH

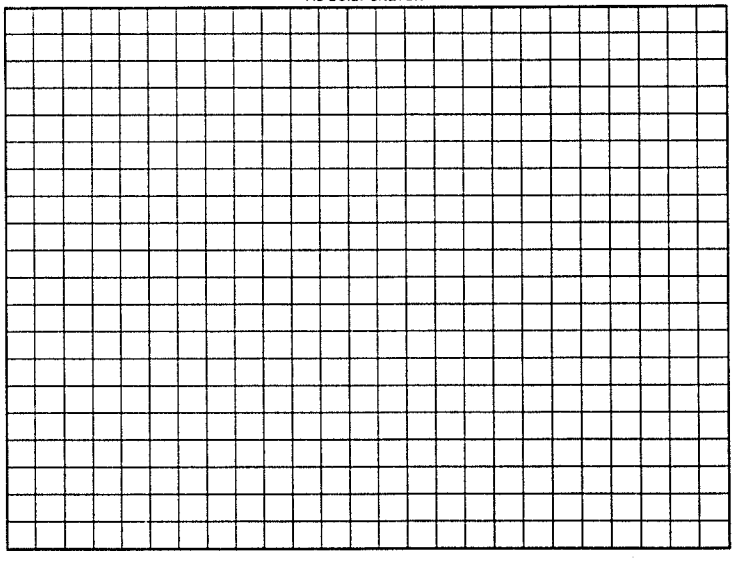

Permit can be suspended or revoked if any false information is supplied toward securing the permit/any unauthorized changes are made to the site/any unauthorized changes are made in the installation of the system. Improvement Permit with plat valid without expiration. Improvement Permit with site plan valid for sixty months. Authorization to Construct is valid for a period equal to that of Improvement Permit – not to exceed sixty months.

Signed: _____ date ____ Installed by: _____

Improvement Permit by: _____ date ____ Operation Permit by: _____ date ____

Authorization to Construct by: _____ date ____ Existing System Inspection by: Joe Potter date ____

HEALTH DEPT. COPY: WHITE OWNER COPY (FINAL): YELLOW OWNER COPY (INITIAL): PINK