IREDELL COUNTY HEALTH DEPARTMENT

Statesville Office (704) 878-5305 Mooresville Office (704) 660-3625

PERMIT # 2114254 ~~21389~~ ~~21327~~

IMPROVEMENT PERMIT / AUTHORIZATION TO CONSTRUCT / OPERATION PERMIT / EXISTING SYSTEM

PIN # 3794283829.491

APPLICANT: Jenny Mullis APPLICANT ADDRESS: 491 New Sterling Rd Stony Point NC

SITE ADDRESS: 491 New Sterling Rd Stony Point NC PHONE: 704-872-1040 ALT. PHONE: 704-838-1200

SITE DIRECTIONS: I40W T/R old Mtn Rd T/L New Sterling RD lot on right


SUBDIVISION: N/A SECTION: N/A LOT # N/A LOT AREA: 4.061 ac DESIGN FLOW: 480 L.T.A.R.: 0.3

Septic Tank	Ex (gal)	STB	Date	☐ New System ☐ Repair ☒ Expansion	System Type: I II III IV V VI	☒ Residence	No. Bedrooms	4	Water Supply
Pump Tank	(gal)	PT	Date	System Description:	25% Reduction	☐ Business	No. Persons	8	☒ Private
Pump Make	Model		Serial #	Repair System Description:	50% Reduction	☐ Other	No. Employees		☐ Public
# Nitrification Fields	1 # Lines	2	Linear Ft: 225'	Maintenance Agreement Required:	☐ YES ☒ NO	☐ Slab	☒ Crawl Space		☐ Community
Trench Width	36" Max. Trench Bottom Depth	36"	Gravel Depth N/A	☒ GRAVITY	☐ PRESSURE	☐ Basement w/ plumbing		☐ Basement w/o plumbing	

Comments / Conditions: Install 25% reduction on contour with Serial distribution. Set new D-box on existing bed. (545 ft)


Disconnect by dam existing bed 5' from Garage. Remove existing pool before final inspection. Check tank, check tee replace if needed

INITIAL SITE SKETCH

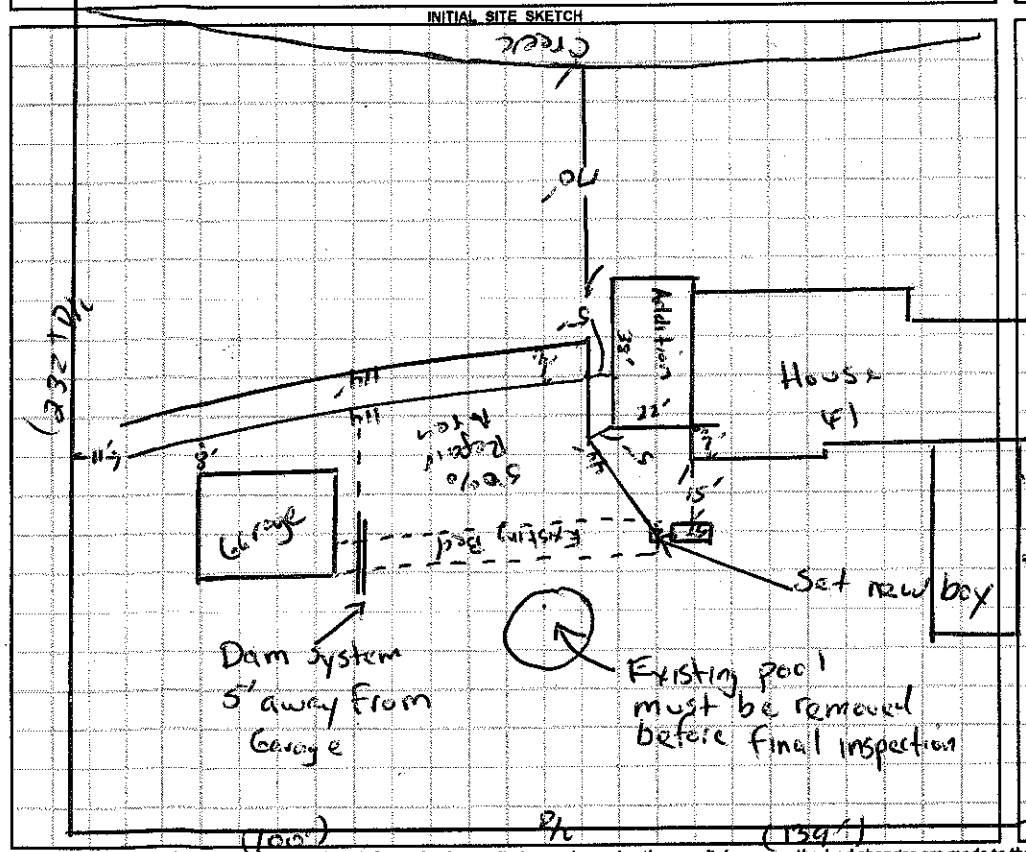

AS BUILT SKETCH

1"=50'

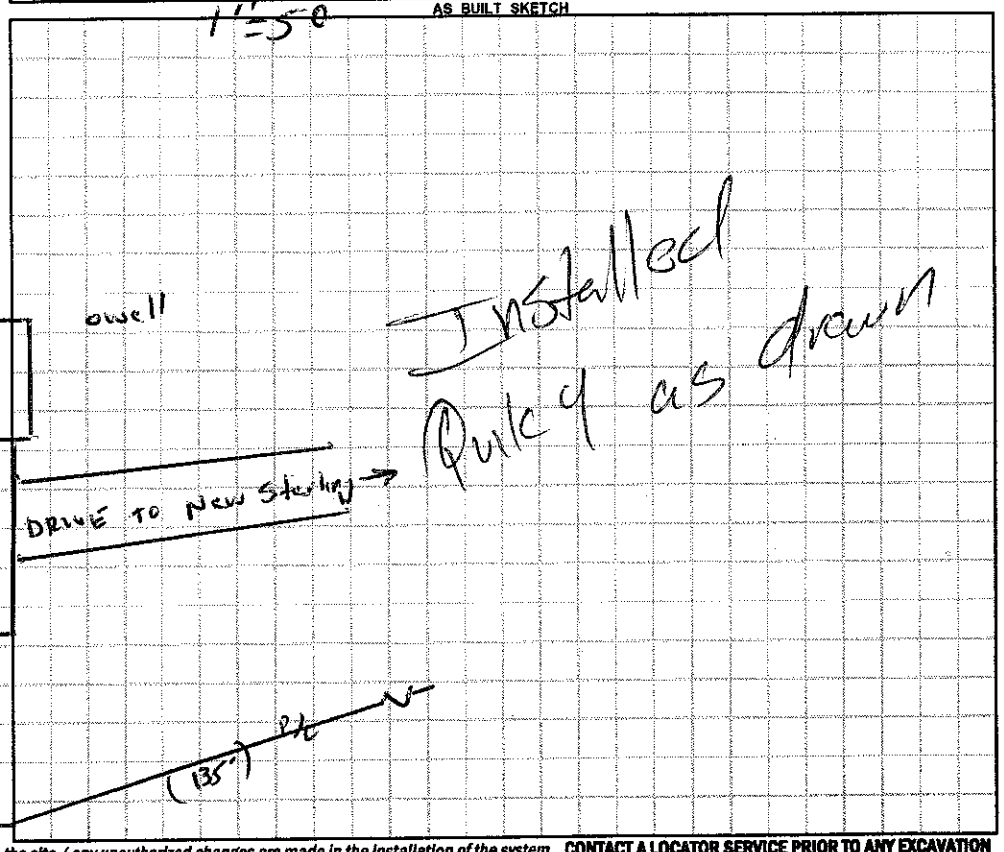

Permit can be suspended or revoked if any false information is supplied toward securing the permit / any unauthorized changes are made to the site / any unauthorized changes are made in the installation of the system. **CONTACT A LOCATOR SERVICE PRIOR TO ANY EXCAVATION**

☐ **IMPROVEMENT PERMIT** *with plat valid without expiration.* ☒ **IMPROVEMENT PERMIT** *with site plan valid for 60 mos.* ☒ **AUTHORIZATION TO CONSTRUCT** *valid for period equal to IMPROVEMENT PERMIT--not to exceed 60 mo.*

Owner / Applicant Signature: Jenny Mullis Date: 10/15/15 Installed by: Marty Tucker

IMPROVEMENT PERMIT by: David A Lang Date: 10/15/15 OPERATION PERMIT by: Date: 08/23/16

AUTHORIZATION TO CONSTRUCT by: David A Lang Date: 10/15/15 Existing System Inspected by: Date:

Health Dept. Copy - WHITE Applicant (Final Approval) - YELLOW Applicant (Conditional Approval) - PINK