IREDELL COUNTY HEALTH DEPARTMENT

Statesville Office (704) 878-5305 Mooresville Office (704) 660-3625 PERMIT # 220106

BA

IMPROVEMENT PERMIT / AUTHORIZATION TO CONSTRUCT / OPERATION PERMIT / EXISTING SYSTEM

PIN # 3794-40-1964

APPLICANT: Yvonne F. Schaeffer APPLICANT ADDRESS: 366 Sycamore Farm Drive Stony Point, NC 28678

SITE ADDRESS: 140 White Rock Farm Lane Statesville, NC 28625 PHONE: 828-308-3436 ALT. PHONE:

SITE DIRECTIONS: I-40 W from Statesville → R on Old Mountain Rd → L on Island Ford Rd → L on Goble Rd → R on White Rock Farm Lane → 2nd R Right End.


SUBDIVISION: N/A - To be subdivided from larger parcel SECTION: LOT #: LOT AREA: 1.691 acres DESIGN FLOW: 240 GPD L.T.A.R.: 0.275

Septic Tank	1000 (gal)	STB	794	Date	9/1/16	☒ New System	☐ Repair	☐ Expansion	System Type: I II III IV V VI	☒ Residence	No. Bedrooms 2
Pump Tank	— (gal)	PT	—	Date	—	System Description: 25% Reduction				☐ Business	No. Persons 4
Pump Make	—	Model	—	Serial #	—	Repair System Description: 25% Reduction				☐ Other	No. Employees
# Nitrification Fields	1	# Lines	4	Linear Ft:	230	Maintenance Agreement Required:	☐ YES	☒ NO		☐ Slab	☒ Crawl Space
Trench Width	36"	Max. Trench Bottom Depth	36"	Gravel Depth	—		☒ GRAVITY	☐ PRESSURE		☐ Basement w/plumbing	☐ Basement w/o plumbing

Water Supply: ☐ Private ☒ Public ☐ Community

Comments / Conditions: Follow all N.C. septic rules. Old stump pit must be filled. Prior to AC being issued, a recorded plat with the Deed Book + Page Number must be provided to the Health Department exactly matching the documention already provided in order for this permit to remain valid. Recommend pumping septic tank every 3-5 years.

INITIAL SITE SKETCH

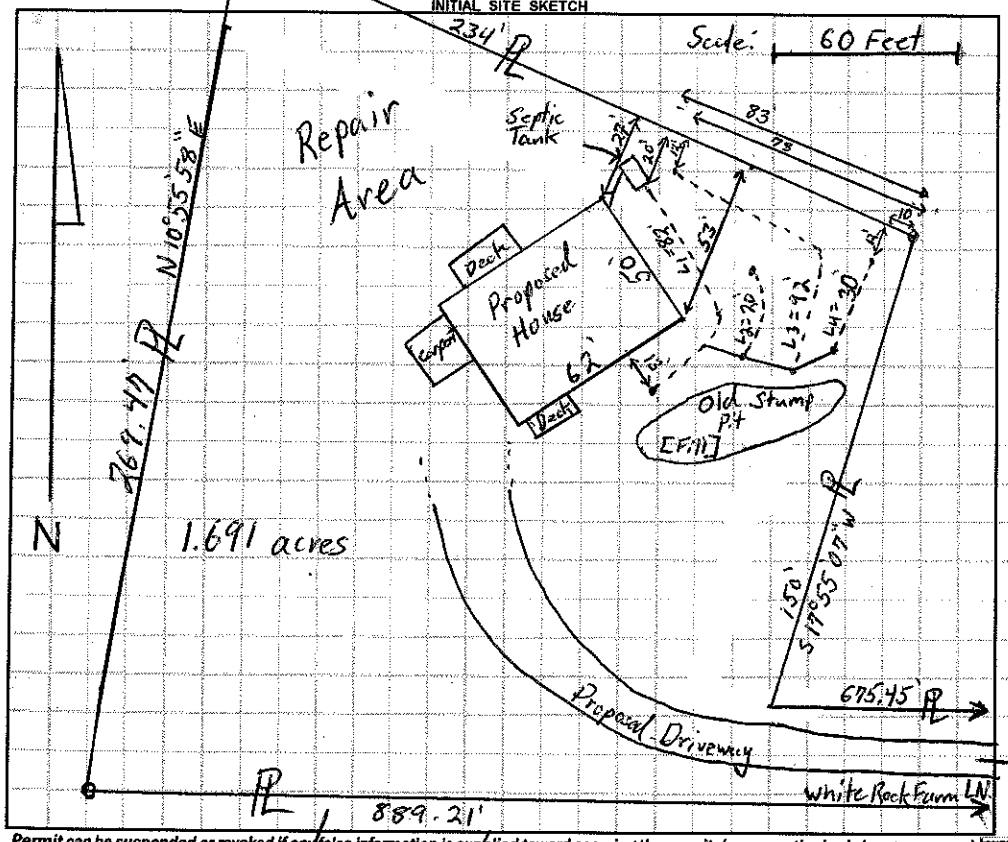

AS BUILT SKETCH

Permit can be suspended or revoked if any false information is supplied toward securing the permit / any unauthorized changes are made in the installation of the system. CONTACT A LOCATOR SERVICE PRIOR TO ANY EXCAVATION

☒ IMPROVEMENT PERMIT with plat valid without expiration. ☐ IMPROVEMENT PERMIT with site plan valid 60 mos. ☒ AUTHORIZATION TO CONSTRUCT valid for period equal to IMPROVEMENT PERMIT--not to exceed 60 mo.

Owner / Applicant Signature: Yvonne Fisher Schaeffer Date: 9-12-16 Installed by: Ritchie Bowman

IMPROVEMENT PERMIT by: Tom Shuck Date: 9-9-201 OPERATION PERMIT by: W Sparks Date: 12/2/16

AUTHORIZATION TO CONSTRUCT by: Tom Shuck Date: 9-9-201 Existing System Inspected by: Date:

Health Dept. Copy - WHITE Applicant (Final Appr - YELLOW Applicant (Conditional Approval) - PINK