Andy Miller 4:00-4:30

IREDELL COUNTY HEALTH DEPARTMENT

STATESVILLE 704-878-5305 MOORESVILLE 704-664-5281 62602

IMPROVEMENT PERMIT / CERTIFICATE OF COMPLETION / OPERATION PERMIT / EXISTING SYSTEM INSPECTION

PROPERTY DESCRIPTION NO. 23996 DATE 7-25-96 TAX MAP NO. 8N-A-21

OWNER OR CONTRACTOR Jamie Marlowe PHONE: Business _____ Home 8724087 Watershed: ☐ Yes ☒ No

ADDRESS 3329 Sunset Ave Statesville NC 28677

LOCATION I-77 Old MR TL Island Ford TR Gable Rd 1st Gravel Drive 300ft to lot

SUBDIVISION _____ BLOCK / SECTION _____ LOT 1 LOT AREA 2 acres SITE CLASS. P/S DESIGN FLOW 360 L.T.A.R. 0.3

Septic Tank: 1000 Gallons; STB 1012 TP Date 5/18/96

Pump Tank: _____ Gallons; PT _____ Date _____

Pump Make: _____ Model _____ Serial No. _____

Nitrification Field: No Fields 1 Square Feet 1200 Linear Feet 400

No Lines 4 Trench Width 36" Max Trench Bottom Depth 36" Gravel Depth 12"

☒ New System ☐ Repair System Type: I, II, III, IV, V, VI

System Description: Gravity Conventional

Repair System Description: Gravity Conventional

Maintenance Agreement Required: ☐ Yes ☐ No

☐ House/Mod. Home ☐ Mobile Home ☐ Business ☐ Other

No. Bedrooms 3 No. Bathrooms 2 No. Employees _____


☐ Slab ☐ Crawl Space ☐ Basement w/plumbing ☐ Basement wo/plumbing

Water Supply: ☒ Individual ☐ Community ☐ Public


Comments:

Comments:

INITIAL SITE SKETCH

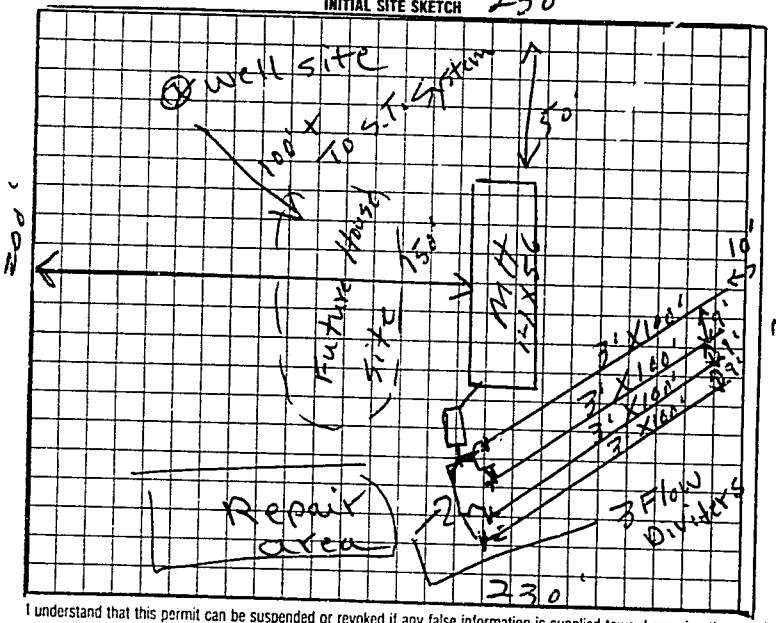

AS BUILT SKETCH

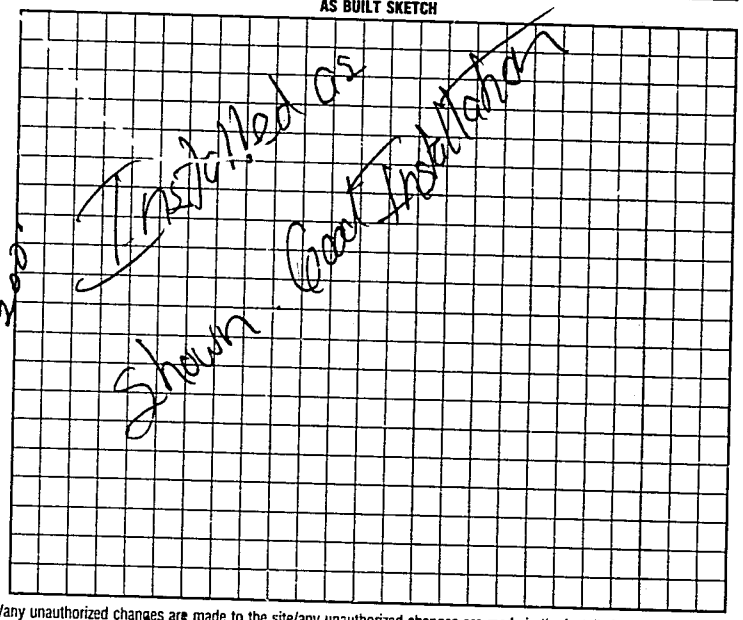

I understand that this permit can be suspended or revoked if any false information is supplied toward securing the permit/any unauthorized changes are made to the site/any unauthorized changes are made in the installation of the system.

Signed: X [signature]

Improvement Permit by: L.C. Moore date 7-25-96

Authorization to Construct Existing System Inspected & Approved to connect. L.C. Moore date 7-25-96

Installed by: Andy Miller

Certificate of Completion by: _____ date _____

Operation Permit by: [signature] date 8/9/96

Authorization to Const. EXPIRES 6 months from issue

HEALTH DEPT. COPY WHITE INSPECTION COPY (FINAL) GREEN OWNER COPY (FINAL) YELLOW INSPECTION COPY (INITIAL) PINK OWNER COPY (INITIAL) GOLD