IREDELL COUNTY HEALTH DEPARTMENT

STATESVILLE 704-878-5305 MOORESVILLE 704-664-5281

IMPROVEMENT PERMIT / AUTHORIZATION TO CONSTRUCT / OPERATION PERMIT / EXISTING SYSTEM INSPECTION

PERMIT# 151861 PIN# 3794402552 DATE 8/8/08

OWNER OR APPLICANT Clayton Homes / Chris & Elizabeth Hedley PHONE: Business 704.873.2547 Home

ADDRESS 125 White Rock Farm Rd. Statesville, NC 28625

LOCATION I-40 W, R off Mm. Rd., R Island Ford, TL Goble, TR White Rock Farm, on Lft.

SUBDIVISION BLOCK / SECTION LOT LOT AREA 2.0 acres SITE CLASS. P.S. DESIGN FLOW 360 g.p.d. L.T.A.R. 0.3

Septic Tank: 1000 Gallons: STB 1012 Date 5/19/96

Pump Tank: Gallons: PT Date

Pump Make: Model Serial No.

Nitrification Field: No. Fields 1 Square Feet 1200 Linear Feet 400

No. Lines 4 Trench Width 36" Max Trench Bottom Depth 36" Gravel Depth

☐ New System ☐ Repair ☐ Expansion System Type: I II III IV V VI

System Description: existing, conventional

Repair System Description: pump 25%

Maintenance Agreement Required: ☐ Yes ☒ No

☒ House/Mod. Home ☐ Mobile Home ☐ Business ☐ Other

No. Bedrooms 3 No. Persons No. Employees


Water Supply: ☒ Individual ☐ Public ☐ Community

☐ Gravity ☐ Pressure ☐ Slab ☒ Crawl Space ☐ Basement w/plumbing ☐ Basement wo/plumbing

Comments:/Conditions:

Comments:/Conditions:

INITIAL SITE SKETCH

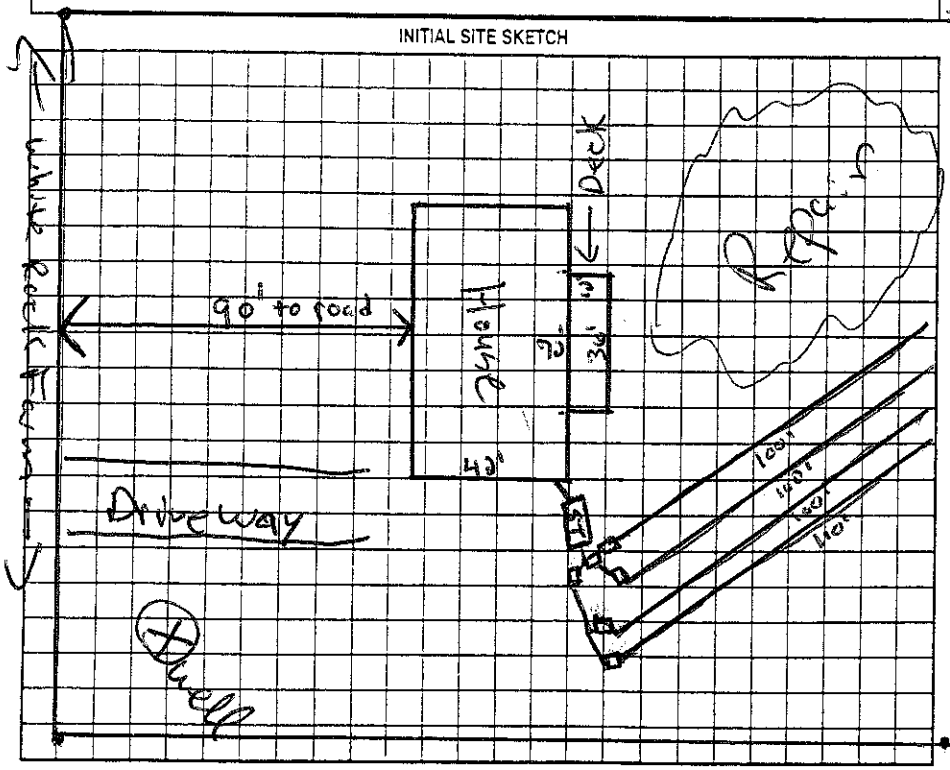

AS BUILT SKETCH

Permit can be suspended or revoked if any false information is supplied toward securing the permit/any unauthorized changes are made to the site/any unauthorized changes are made in the installation of the system. Improvement Permit with plat valid without expiration ☐ Improvement Permit with site plan valid for sixty months ☐ Authorization to Construct is valid for a period equal to that of Improvement Permit – not to exceed sixty months.

Signed: date 8-13-08 Installed by:

Improvement Permit by: date Operation Permit by: date

Authorization to Construct by: date Existing System Inspection by: Rand Mc date 8/8/08

HEALTH DEPT. COPY: WHITE OWNER COPY (FINAL): YELLOW OWNER COPY (INITIAL): PINK